

R-9424
RECEIVED 62566

Form OR-010-7300-2
4/83

UNITED STATES
DEPARTMENT OF THE INTERIOR
BUREAU OF LAND MANAGEMENT

SEP 2 1983
WATER RESOURCES DEPT.
SALEM, OREGON

Section 2,3,10,11


Township 41S

Appl. No. R-65848

Range 14½ E

Permit No. R 9424

Will. Mer.

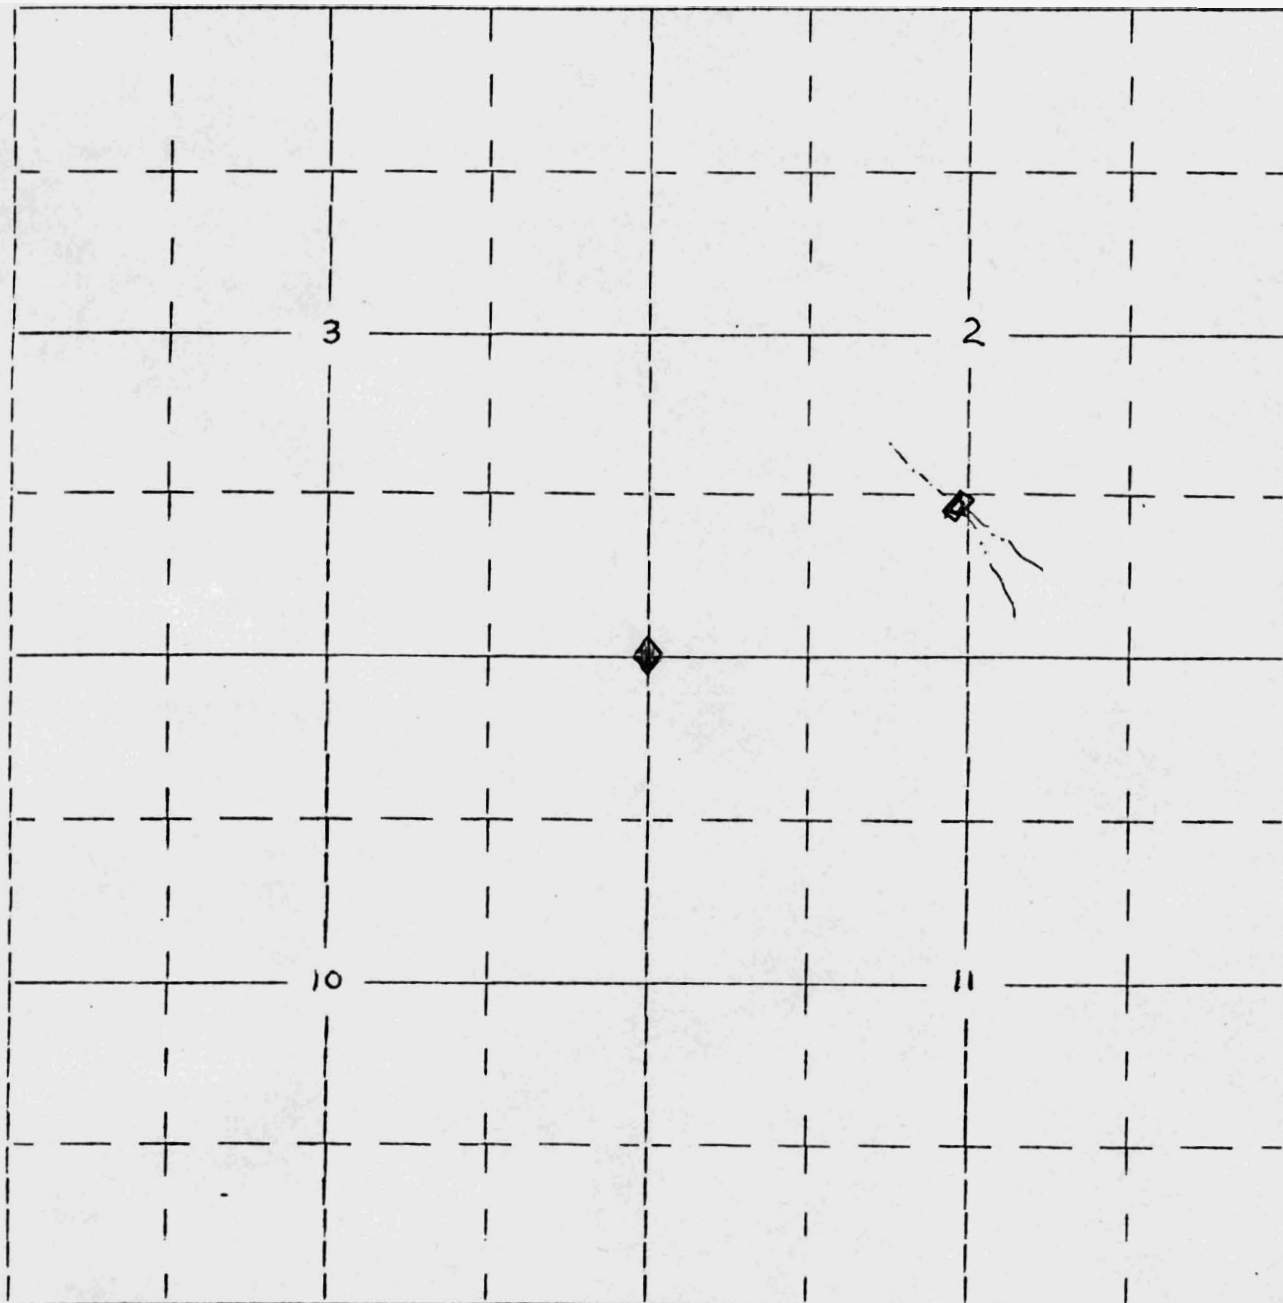

WATERHOLE IS 2640' EAST AND 1300' NORTH OF CORNER COMMON TO
2,3,10,11