

RECEIVED R-9425
62567
SEP 2 1983
WATER RESOURCES DEPT.
SALEM, OREGON

Form OR-010-7300-2
4/83

UNITED STATES
DEPARTMENT OF THE INTERIOR
BUREAU OF LAND MANAGEMENT

Section

1, 6, 31, 36


Township 41S

Range 14 1/2 E

Appl. No. R-65849

Permit No. R 9125

Will. Mer.

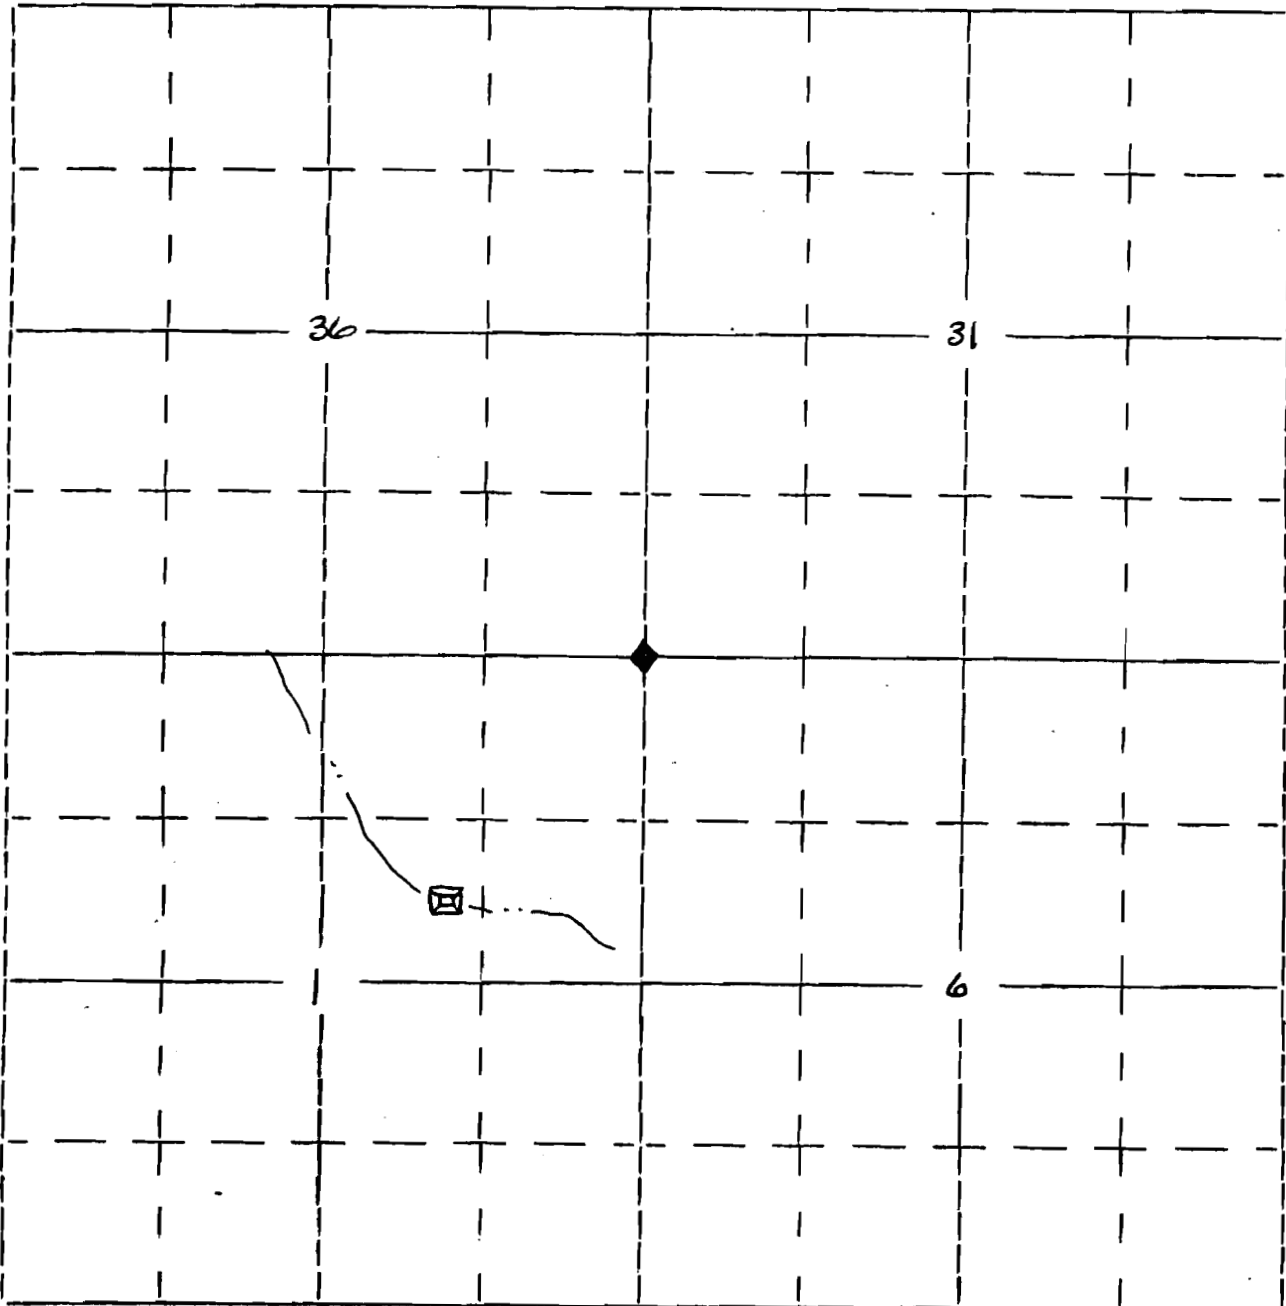

WATERHOLE IS 1980' SOUTH AND 1584' WEST OF CORNER COMMON
TO 1, 6, 31, 36