

R-9426
62568

RECEIVED

SEP 2 1983
WATER RESOURCES DEPT.
SALEM, OREGON


Form OR-010-7300-2
4/83

UNITED STATES
DEPARTMENT OF THE INTERIOR
BUREAU OF LAND MANAGEMENT

Section
4, 5, 8 & 9

Township 41 S.
Range 14 E.
Will. Mer.

Appl. No. R-65850
Permit No. R 9426

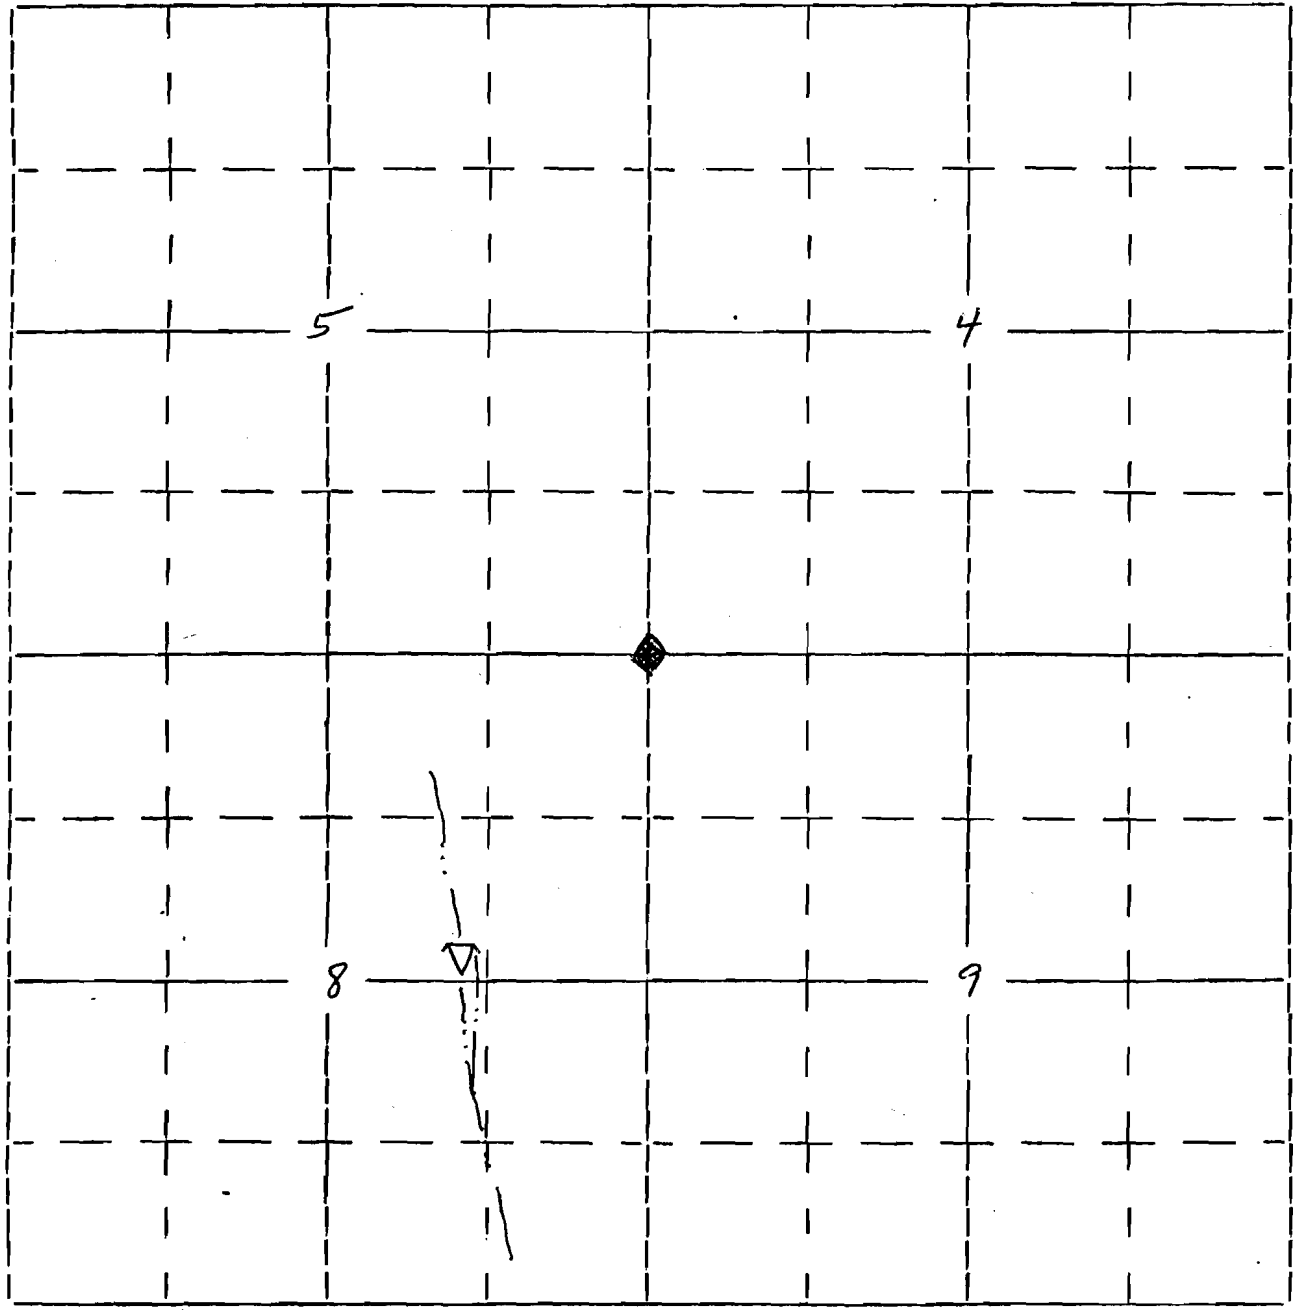

Project is located 2000' south and 1437' west of corner common to sections 4, 5, 8 & 9.