

R-9427
62569

RECEIVED

SEP 2 1983


Form OR-010-7300-2
4/83

UNITED STATES
DEPARTMENT OF THE INTERIOR
BUREAU OF LAND MANAGEMENT

Section
36, 1, 6 & 31

Township 40 S.
41 S.
Range 14 E. 1/4 E.
Will. Mer.

Appl. No. R-65851
Permit No. R 9427

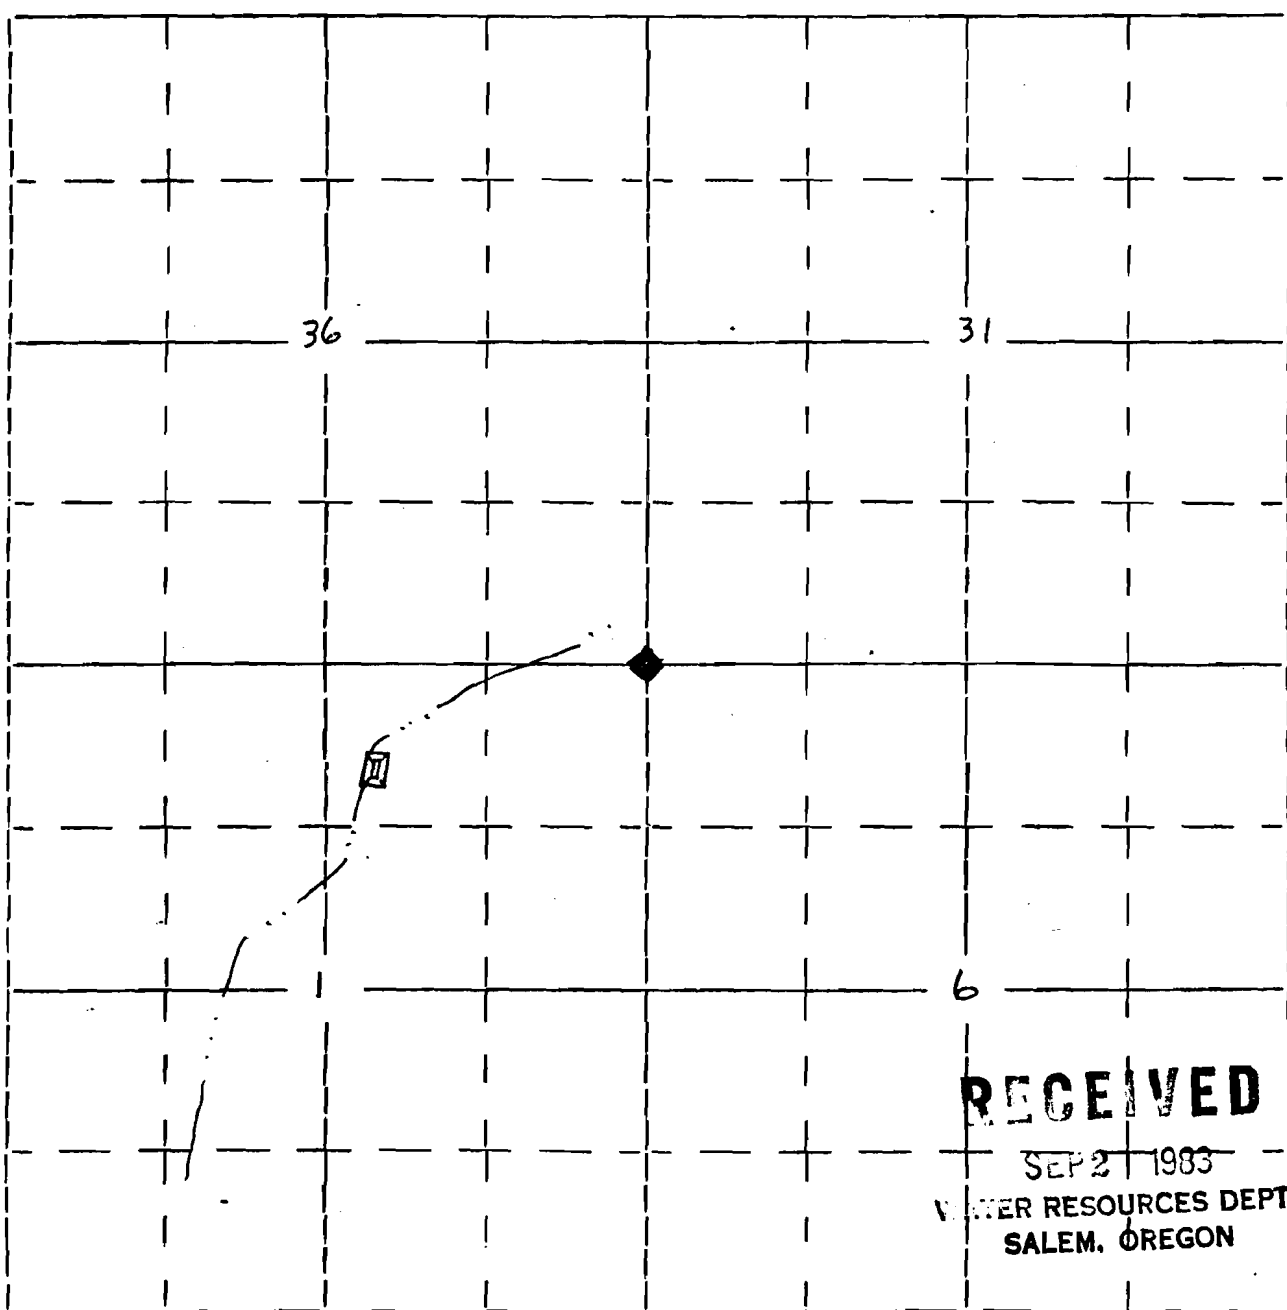

RECEIVED

SEP 2 1983

WATER RESOURCES DEPT.
SALEM, OREGON

Waterhole is 2,218 west and 1,280' south of corner common
to sections 36, 1, 6 & 31.