

R-9428
62570

RECEIVED

Form OR-010-7300-2
4/83

UNITED STATES
DEPARTMENT OF THE INTERIOR
BUREAU OF LAND MANAGEMENT

SEP 2 1983
WATER RESOURCES DEPT.
SALEM, OREGON

Section

17, 18, 19 & 20


Township 41 S.

Range 13 E.

Appl. No. R-65852

Permit No. R 9428

Will. Mer.

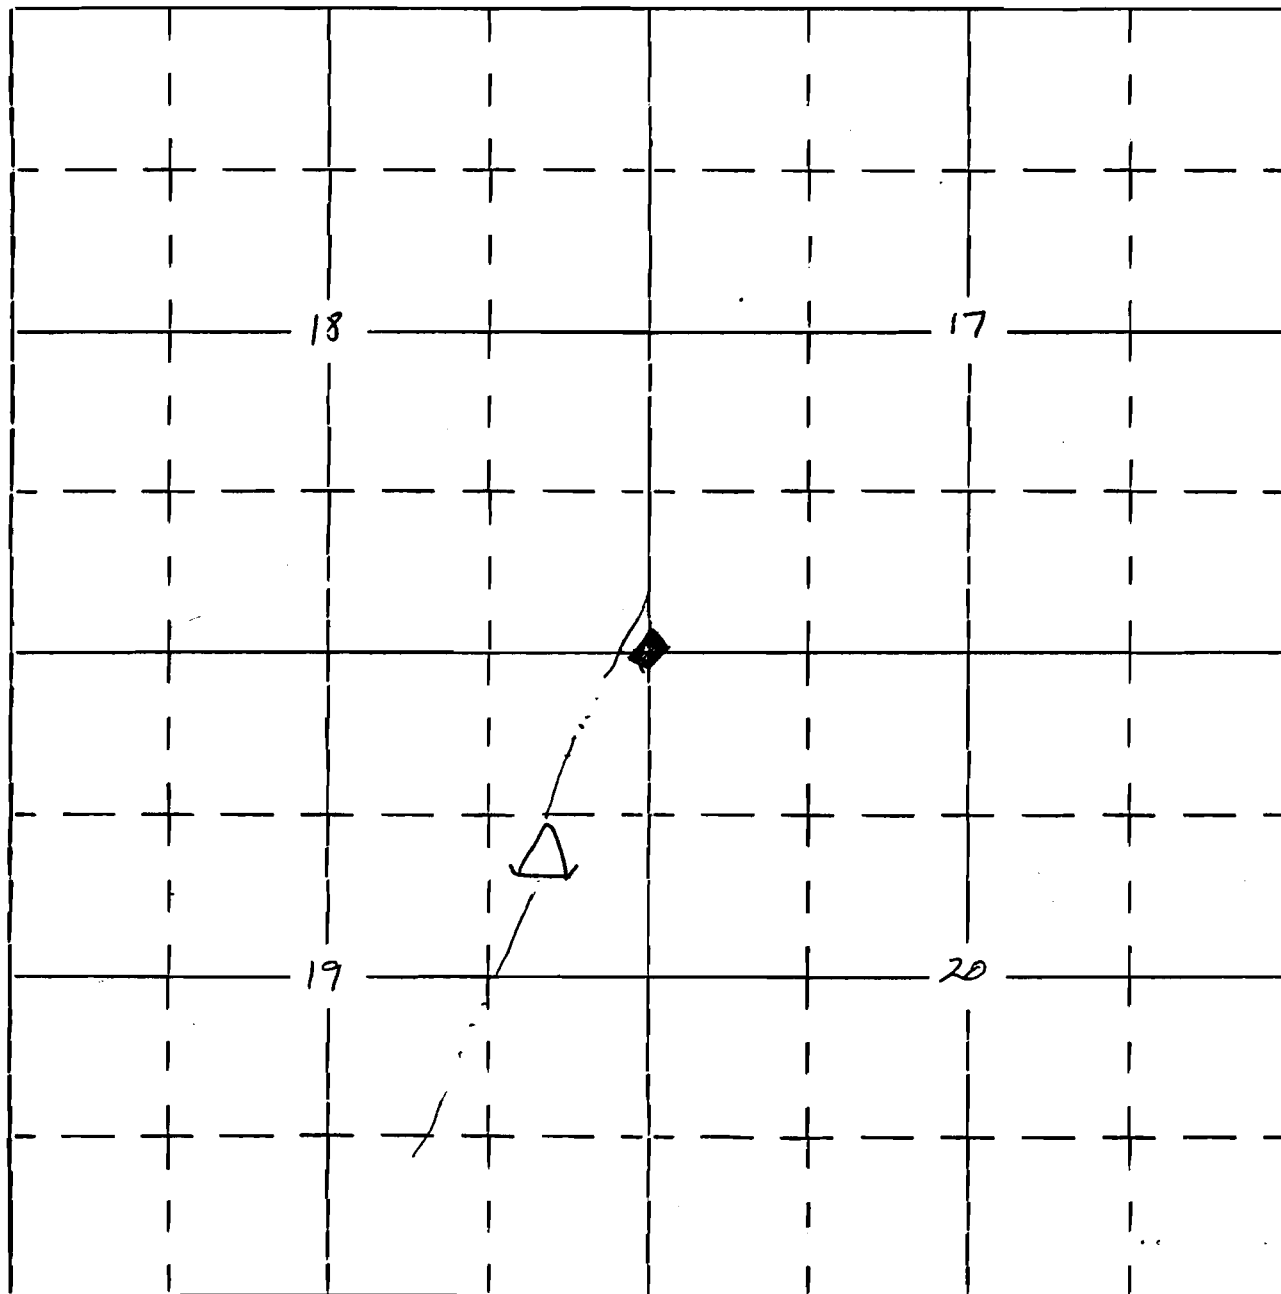

Project is located 1432' south and 955' west of corner
common to sections 17, 18, 19 & 20.