

R-9429
62571

RECEIVED

Form OR-010-7300-2
4/83

UNITED STATES
DEPARTMENT OF THE INTERIOR
BUREAU OF LAND MANAGEMENT

SEP 2 1983
WATER RESOURCES DEPT.
SALEM, OREGON

Section

Township 41 S.


Appl. No. R-65853

7, 8, 17 & 18

Range 13 E.

Permit No. R 9429

Will. Mer.

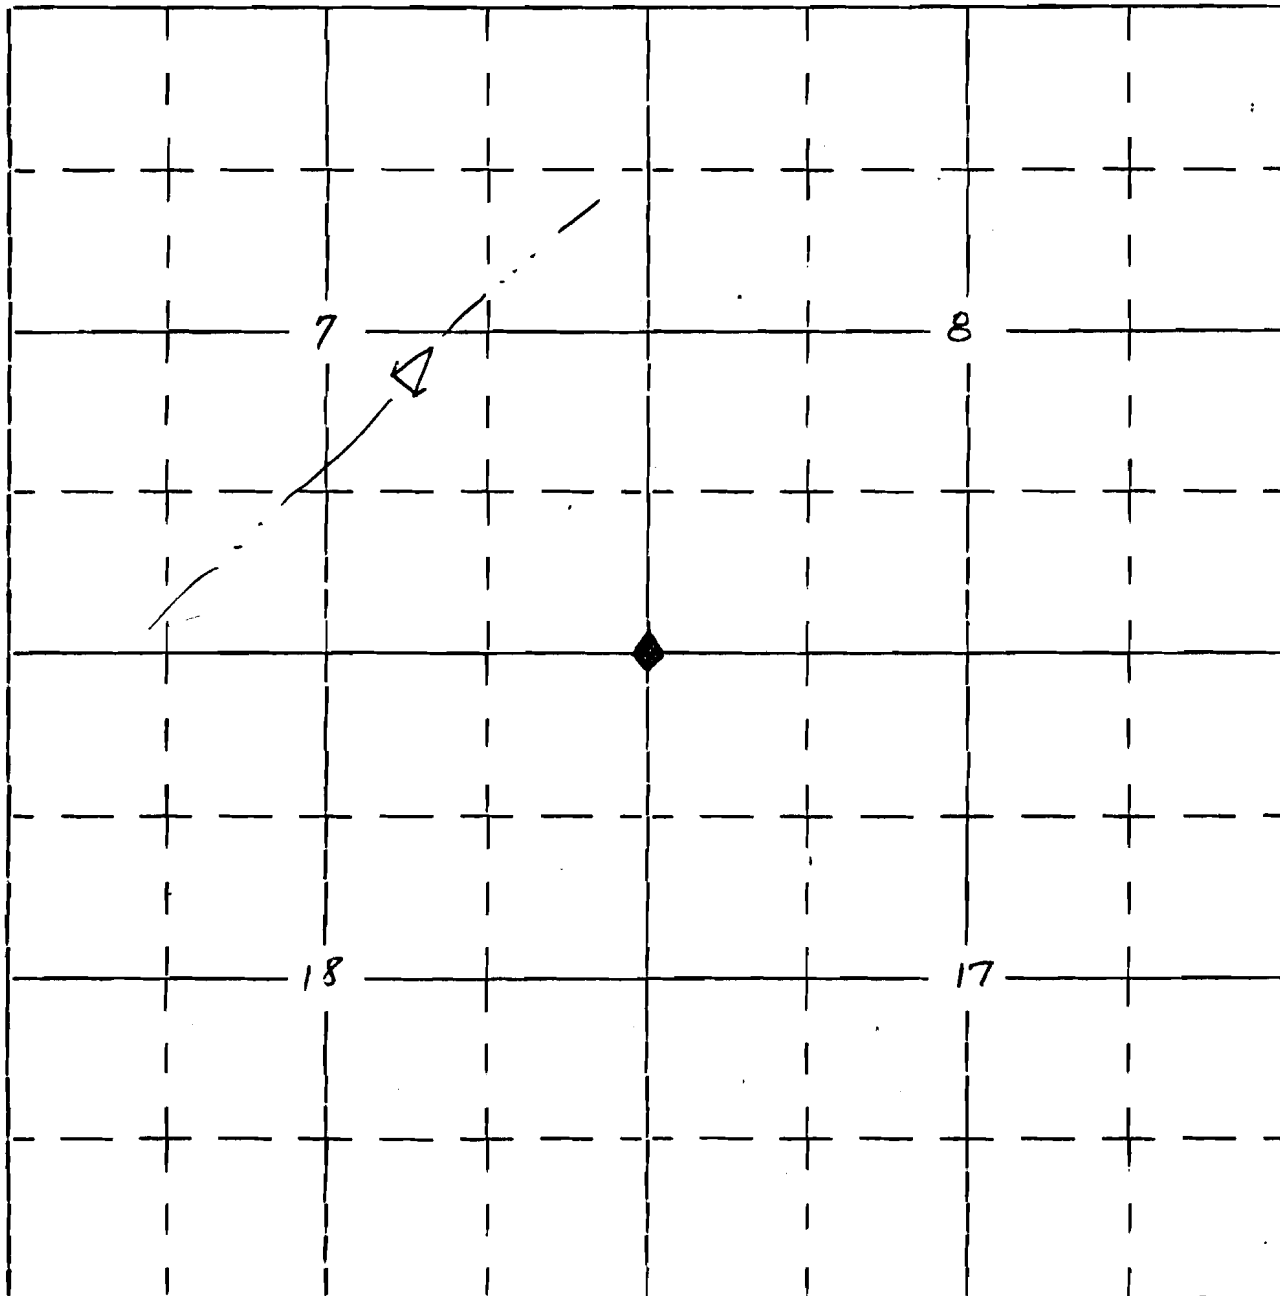

Project is located 2,386' north and 1,999' west of the corner
Common to sections 7, 8, 17 & 18.