

RECEIVED R 9430
62572

SEP 2 1983
WATER RESOURCES DEPT.
SALEM, OREGON

Form OR-010-7300-2
4/83

UNITED STATES
DEPARTMENT OF THE INTERIOR
BUREAU OF LAND MANAGEMENT

Section

6, 7, 17 & 18


Township 41 S.

Range 13 E.

Appl. No. R-65854

Permit No. R 9430

Will. Mer.

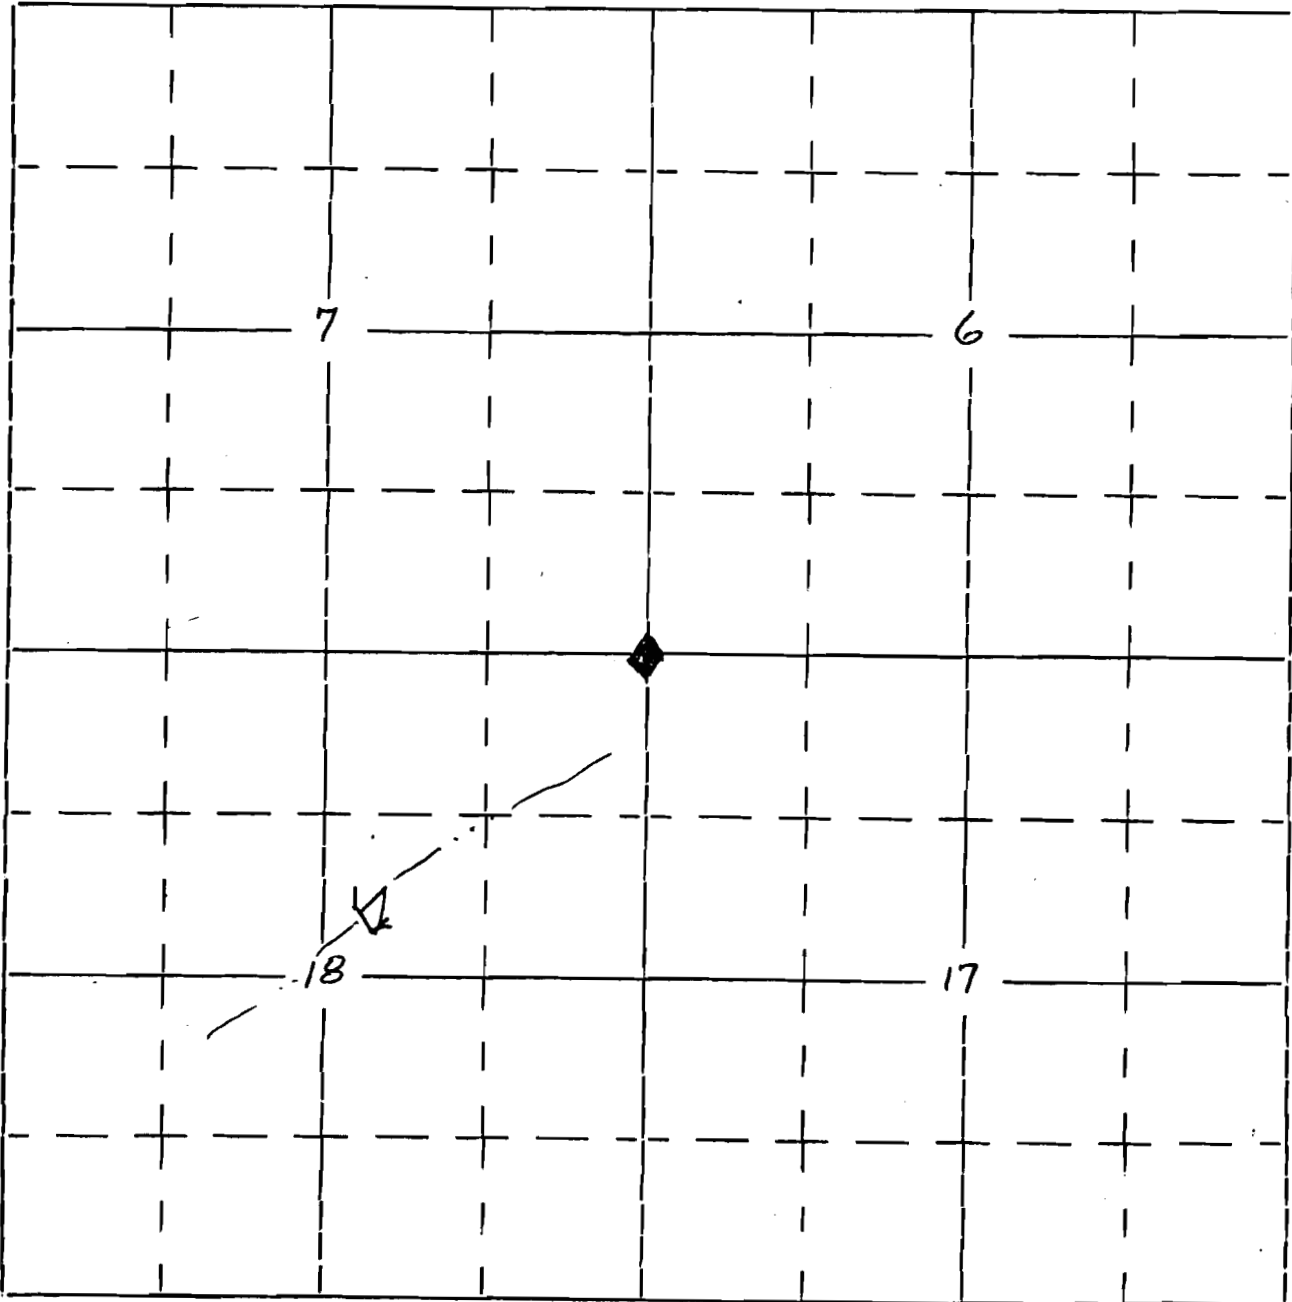

Project is located 1,700' south and 2,327' west of corner common to sections 6, 7, 17 & 18.