

R-9431
62573

RECEIVED

SEP 2 1983
WATER RESOURCES DEPT.
SALEM, OREGON


Form OR-010-7300-2
4/83

UNITED STATES
DEPARTMENT OF THE INTERIOR
BUREAU OF LAND MANAGEMENT

Section
5, 6, 7, 8

Township 41 S.
Range 13 E.
Will. Mer.

Appl. No. R-65855
Permit No. R 9431

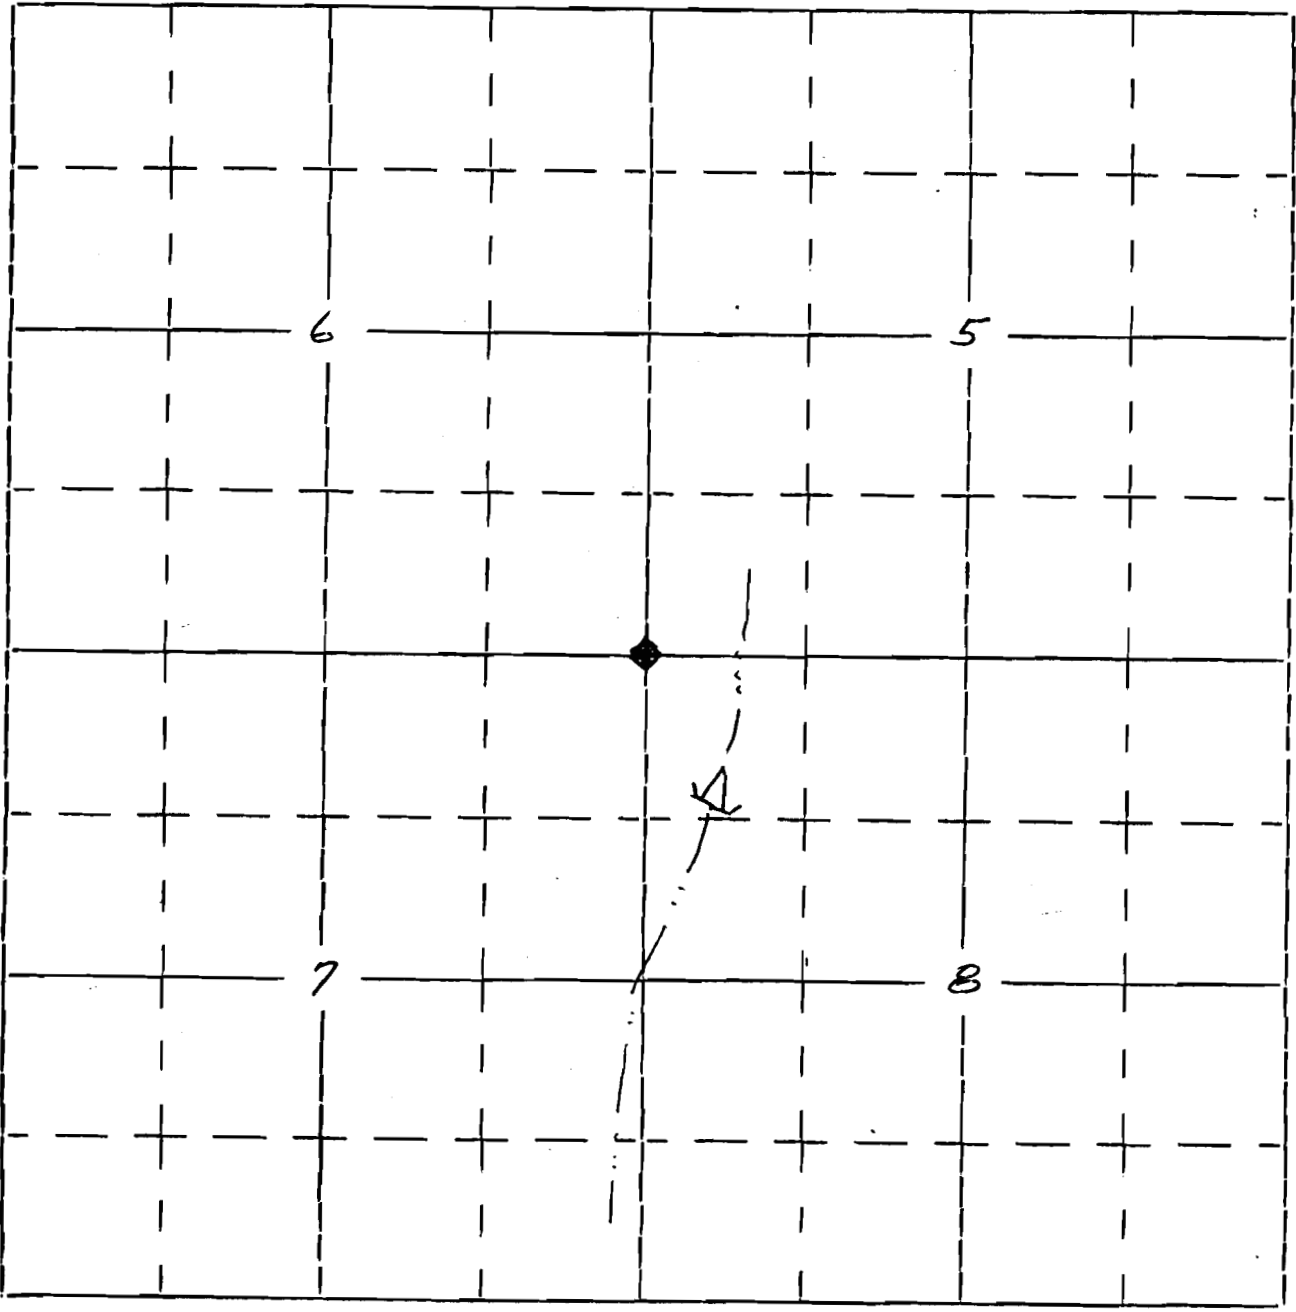

Project is located 686' east and 1,253 south of corner
Common to sections 5, 6, 7 & 8.