

R 9432  
62574

RECEIVED

Form OR-010-7300-2  
4/83


UNITED STATES  
DEPARTMENT OF THE INTERIOR  
BUREAU OF LAND MANAGEMENT

SEP 2 1983  
WATER RESOURCES DEPT.  
SALEM, OREGON

Section  
5, 6, 7 & 8

Township 40 S.  
Range 11 E.  
Will. Mer.

Appl. No. R-65856  
Permit No. R 9432

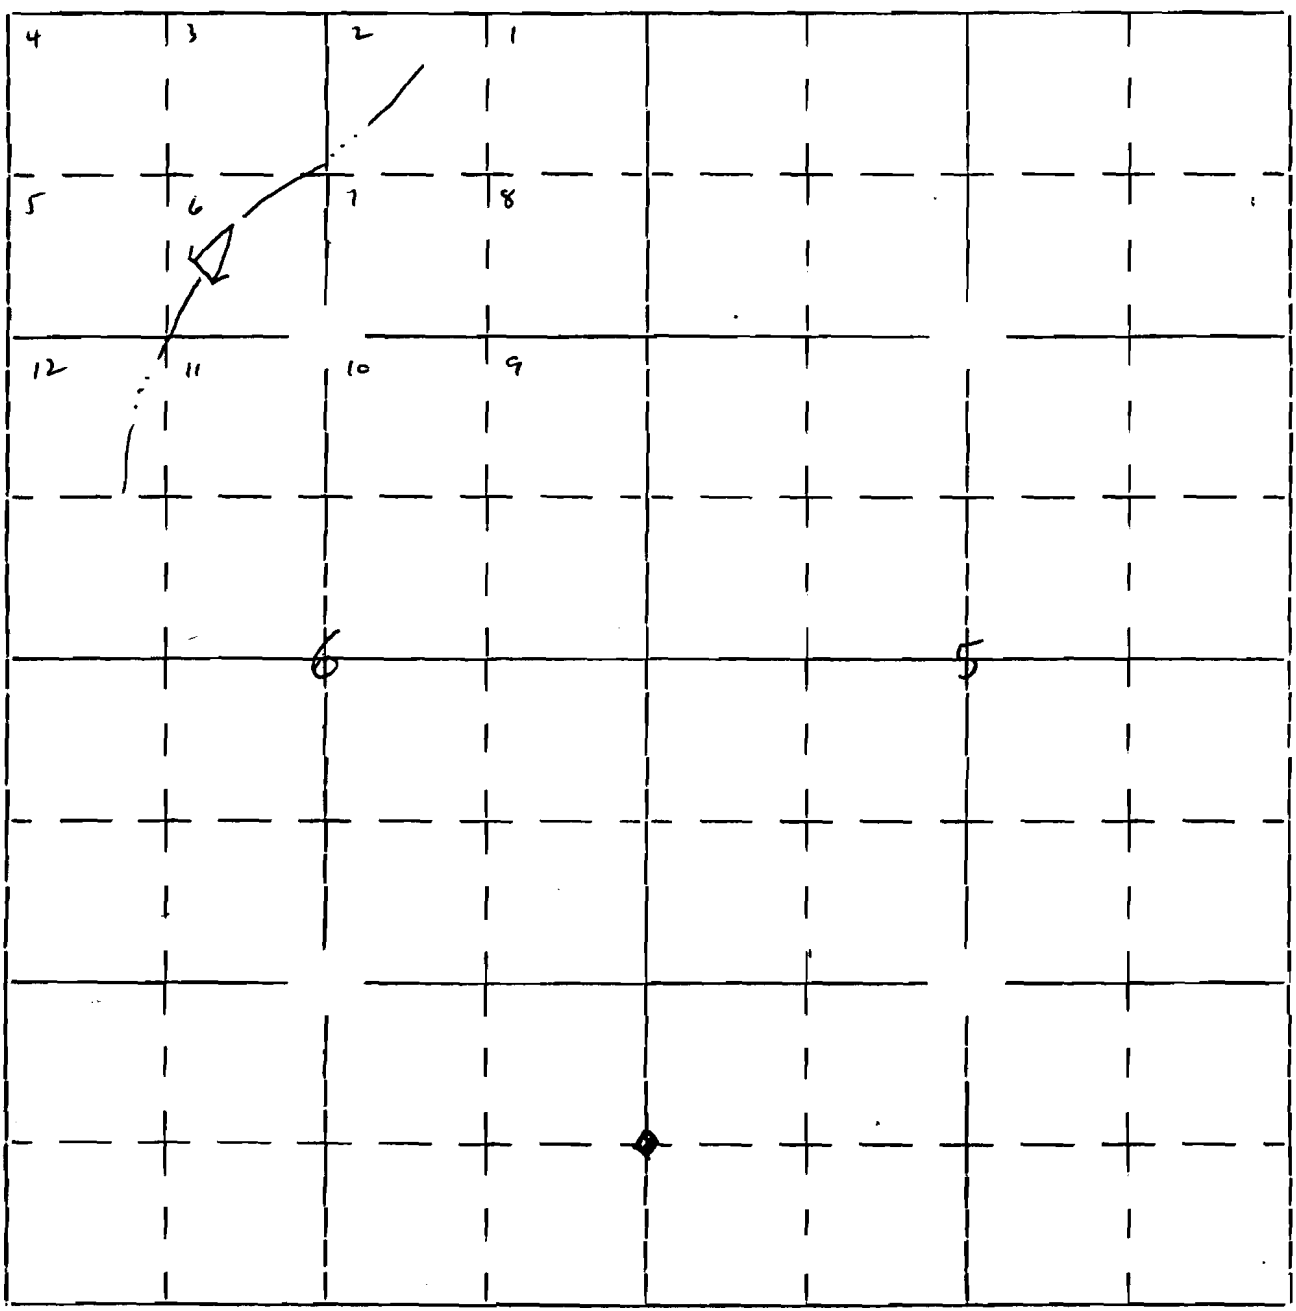

7 8  
Project is located 7,755' north and 2,805' west of corner  
Common to sections 5, 6, 7, & 8.