

R-9433  
**RECEIVED** 02575

SEP 2 1983  
WATER RESOURCES DEPT.  
SALEM, OREGON


Form OR-010-7300-2  
4/83

UNITED STATES  
DEPARTMENT OF THE INTERIOR  
BUREAU OF LAND MANAGEMENT

Section  
5, 6, 7 & 8

Township 40 S.  
Range 11 E.  
Will. Mer.

Appl. No. R-65857  
Permit No. R 9433

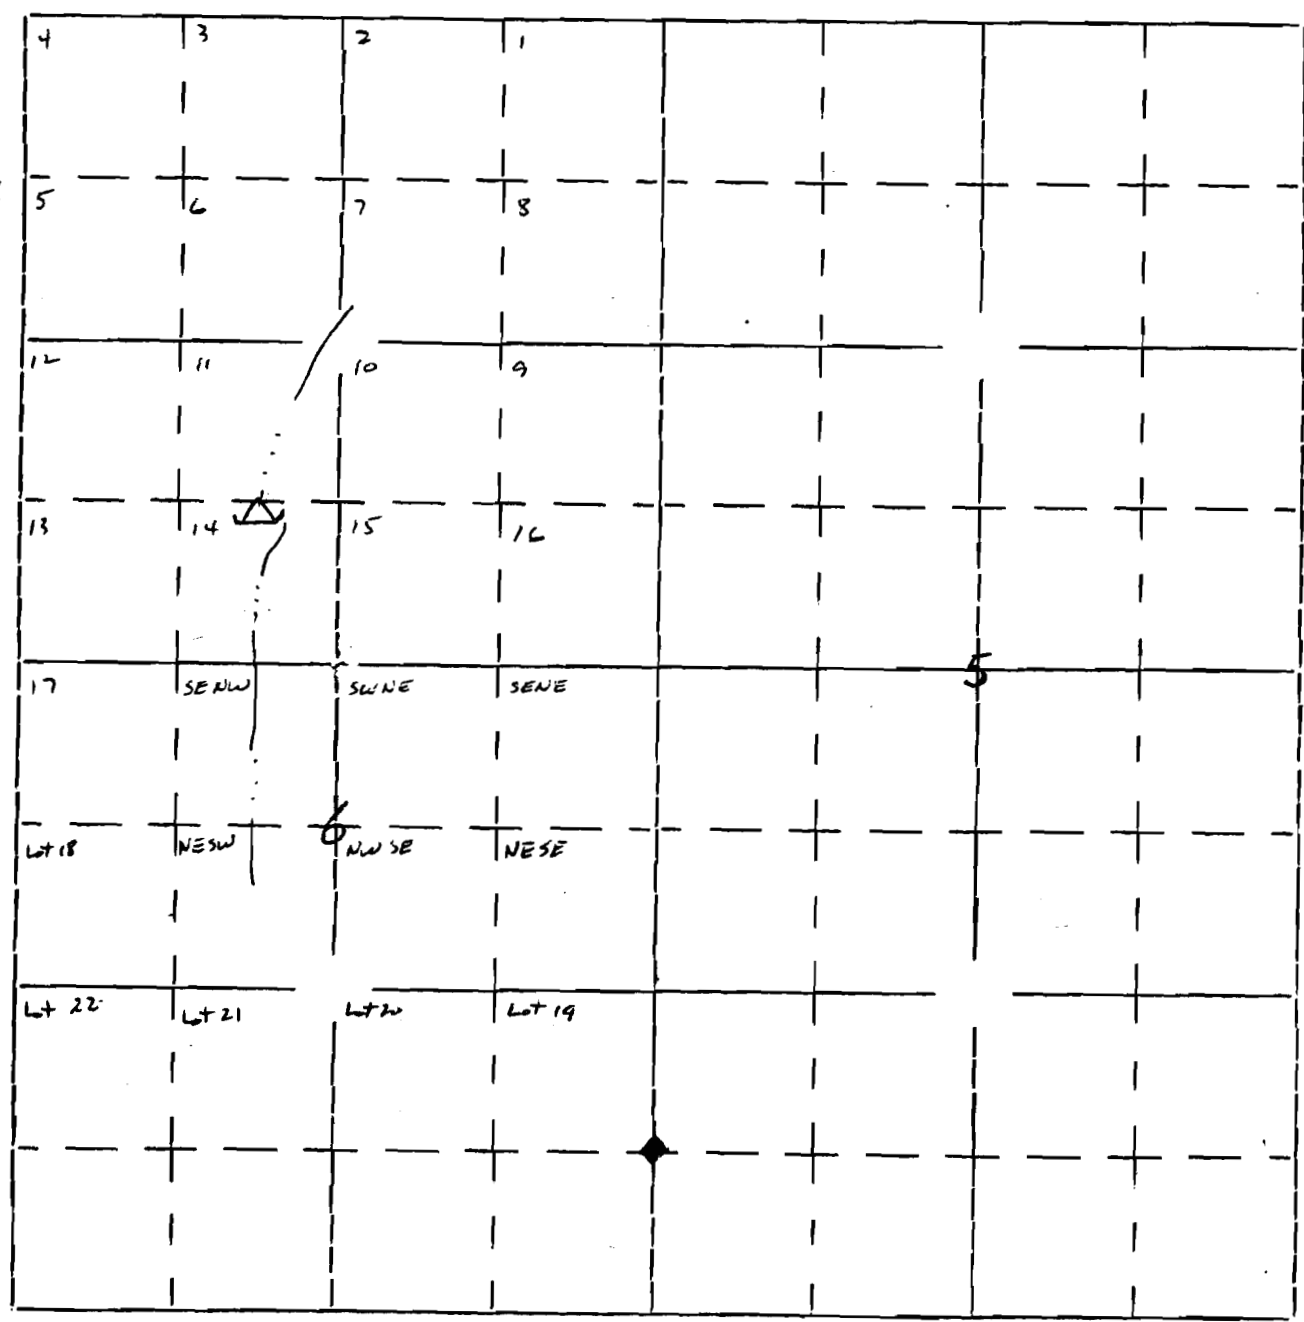

Project is located 5,280' north and 3,300' west of corner common to sections 5, 6, 7 & 8.