

R-9434
RECEIVED 62576

SEP 2 1983
WATER RESOURCES DEPT.
SALEM, OREGON

Form OR-010-7300-2
4/83


UNITED STATES
DEPARTMENT OF THE INTERIOR
BUREAU OF LAND MANAGEMENT

Section

5, 6, 7 & 8

Township 40 S
Range 11 E
Will. Mer.

Appl. No. R-65858
Permit No. R 9434

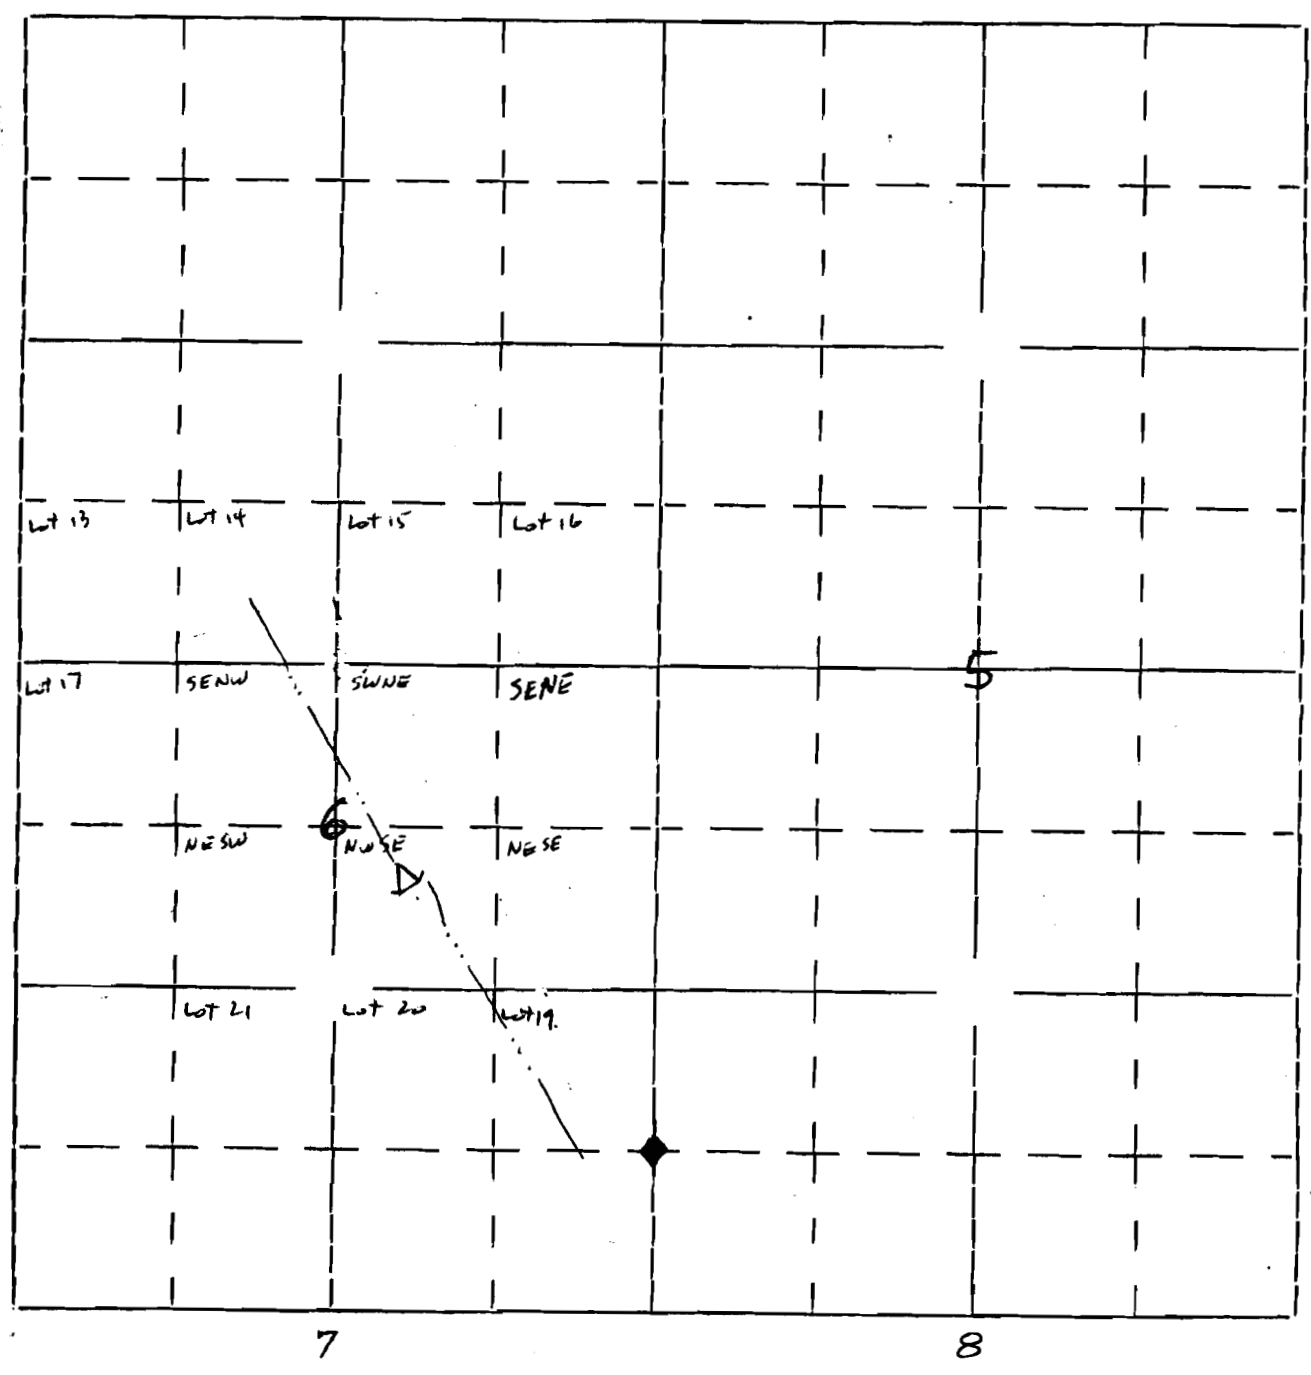

Project is located 2,312' north and 1,718' west of corner common to
Sections 5, 6, 7 & 8.