

R-9435
62877

RECEIVED

SEP 2 1983


Form OR-010-7300-2
4/83

UNITED STATES
DEPARTMENT OF THE INTERIOR WATER RESOURCES DEPT.
BUREAU OF LAND MANAGEMENT SALEM, OREGON

Section
25, 26, 35 & 36

Township 38 S.
Range 13 E.
Will. Mer.

Appl. No. R-65859
Permit No. R 9435

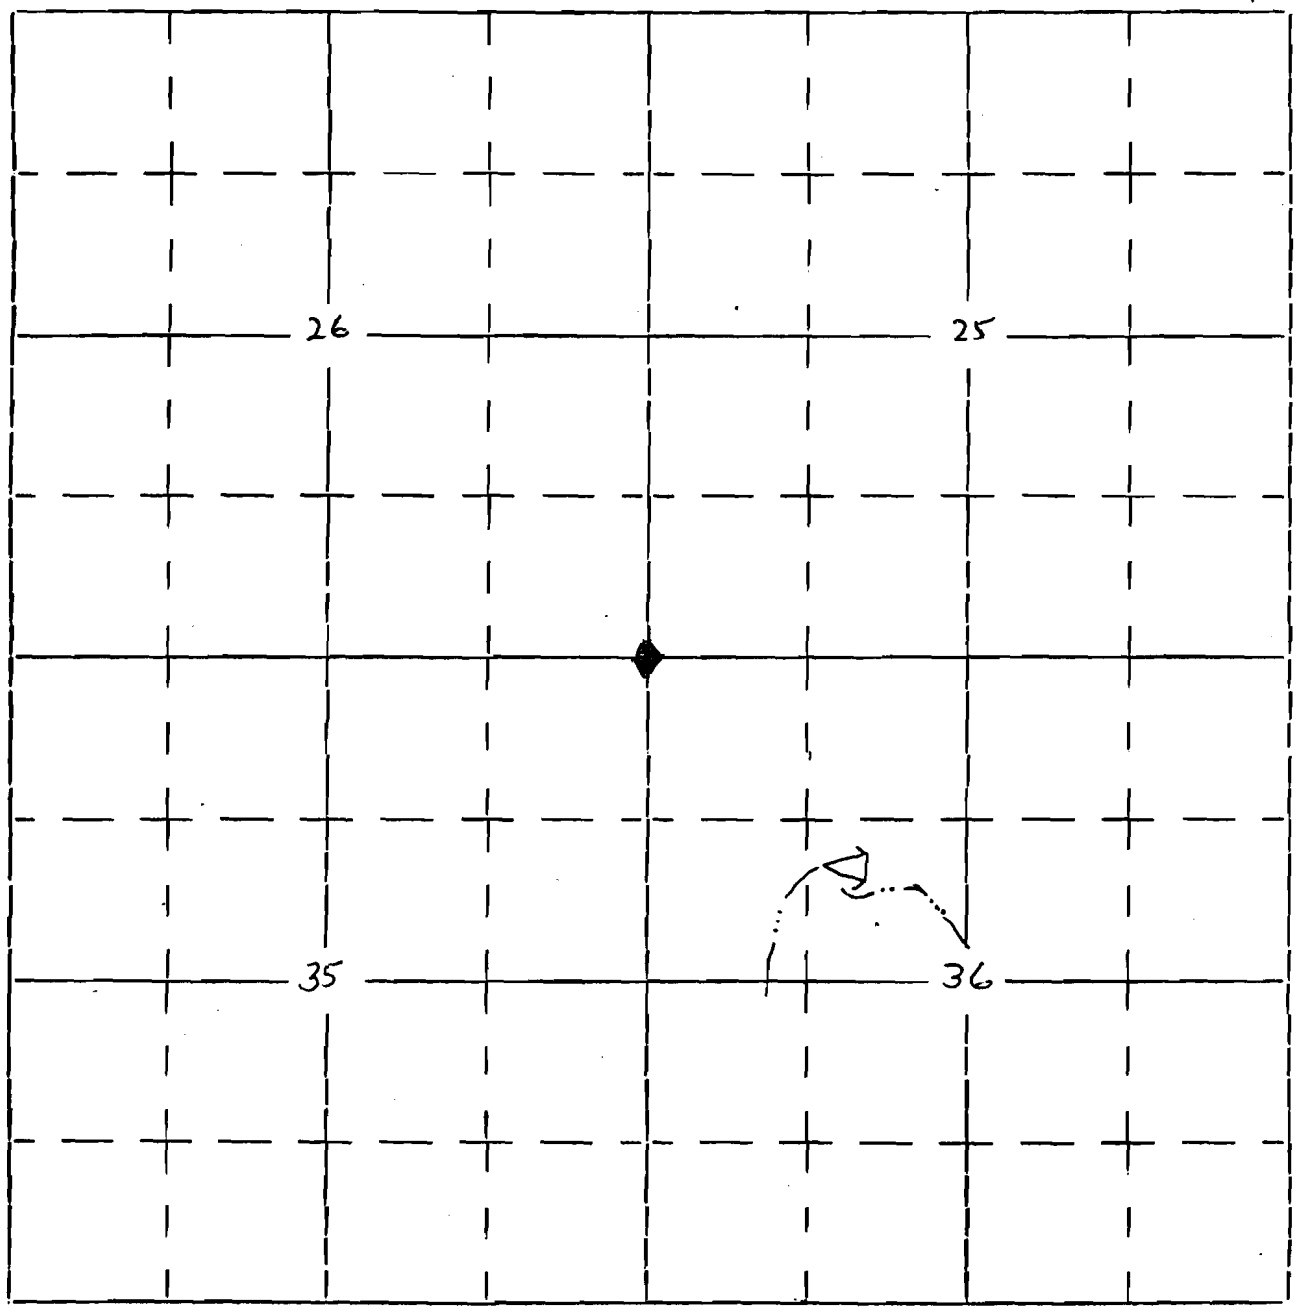

Project is located 1937' south and 1500' east of corner common to sections 25, 26, 35 & 36.