

Form OR-010-7300-2
4/83

UNITED STATES
DEPARTMENT OF THE INTERIOR
BUREAU OF LAND MANAGEMENT

RECEIVED R-9436
62578

SEP 2 1983

WATER RESOURCES DEPT.
SALEM, OREGON

Section

10, 11, 14, 15


Township 41S

Appl. No. R-65860

Range 14 1/2 E

Permit No. R 9436

Will. Mer.

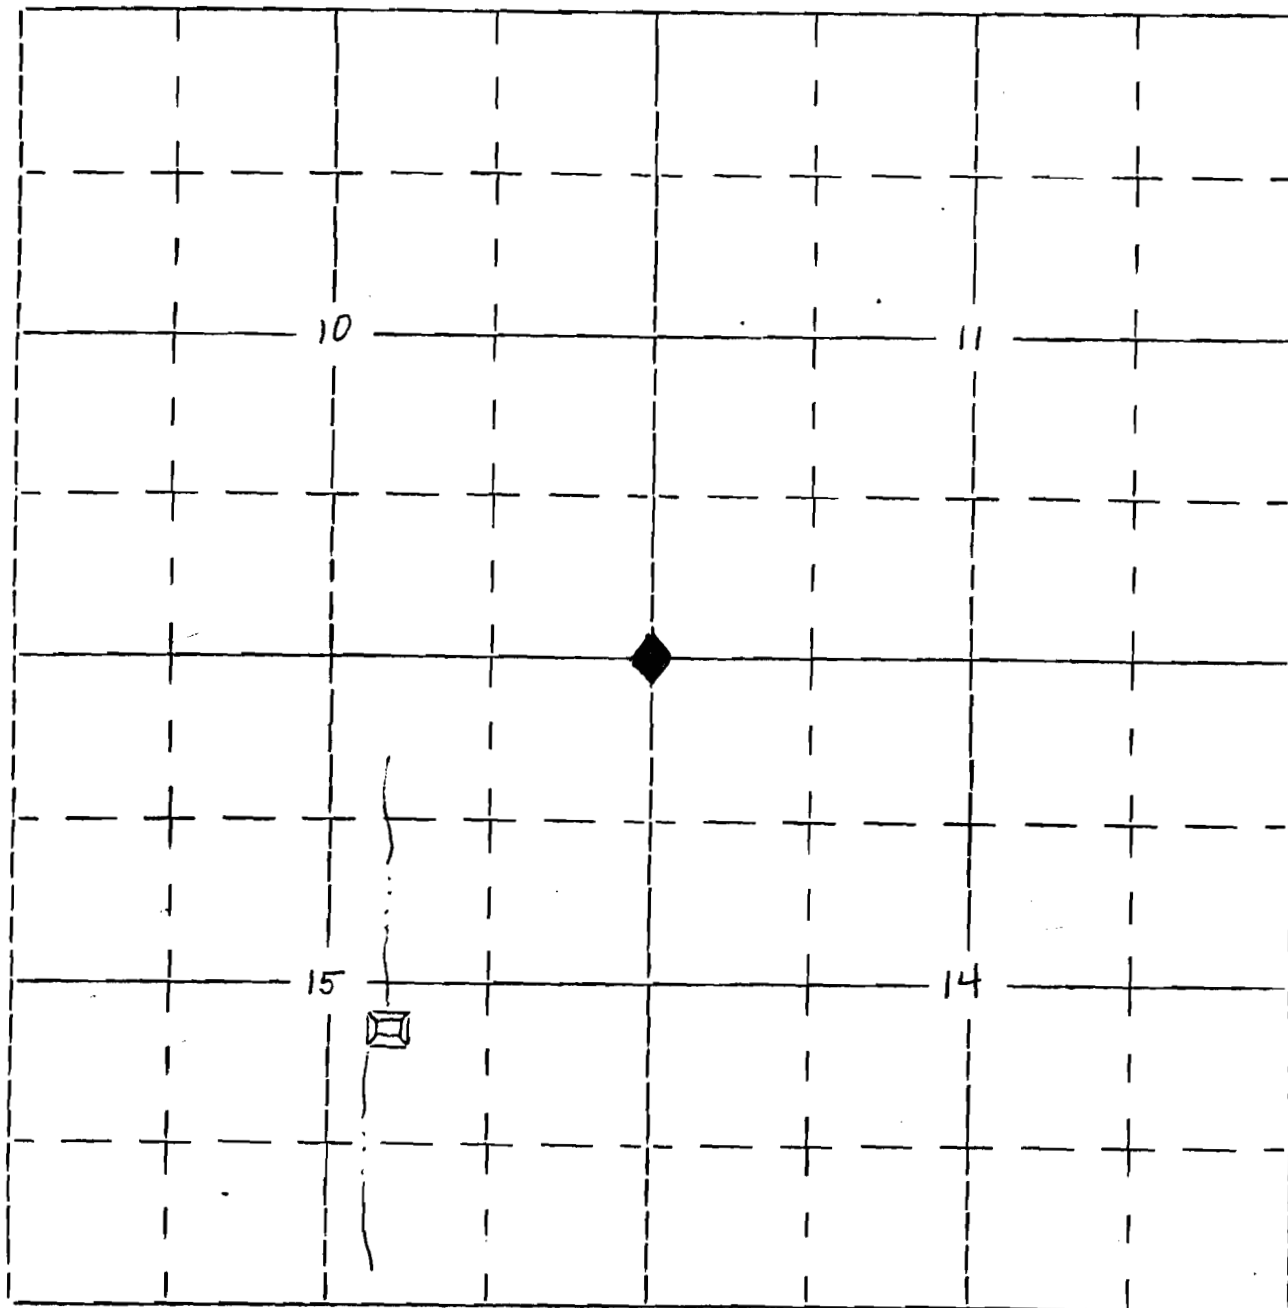

WATERHOLE IS 3170' SOUTH AND 2510' WEST OF CORNER
COMMON TO 10, 11, 14, 15