

R-9437
62579

RECEIVED

SEP 2 1983
WATER RESOURCES DEPT.
SALEM, OREGON

Form OR-010-7300-2
4/83

UNITED STATES
DEPARTMENT OF THE INTERIOR
BUREAU OF LAND MANAGEMENT

Section

Township 41 S.


Appl. No. R-65862

16, 17, 20 & 21

Range 14 E.

Permit No. R 9437

Will. Mer.

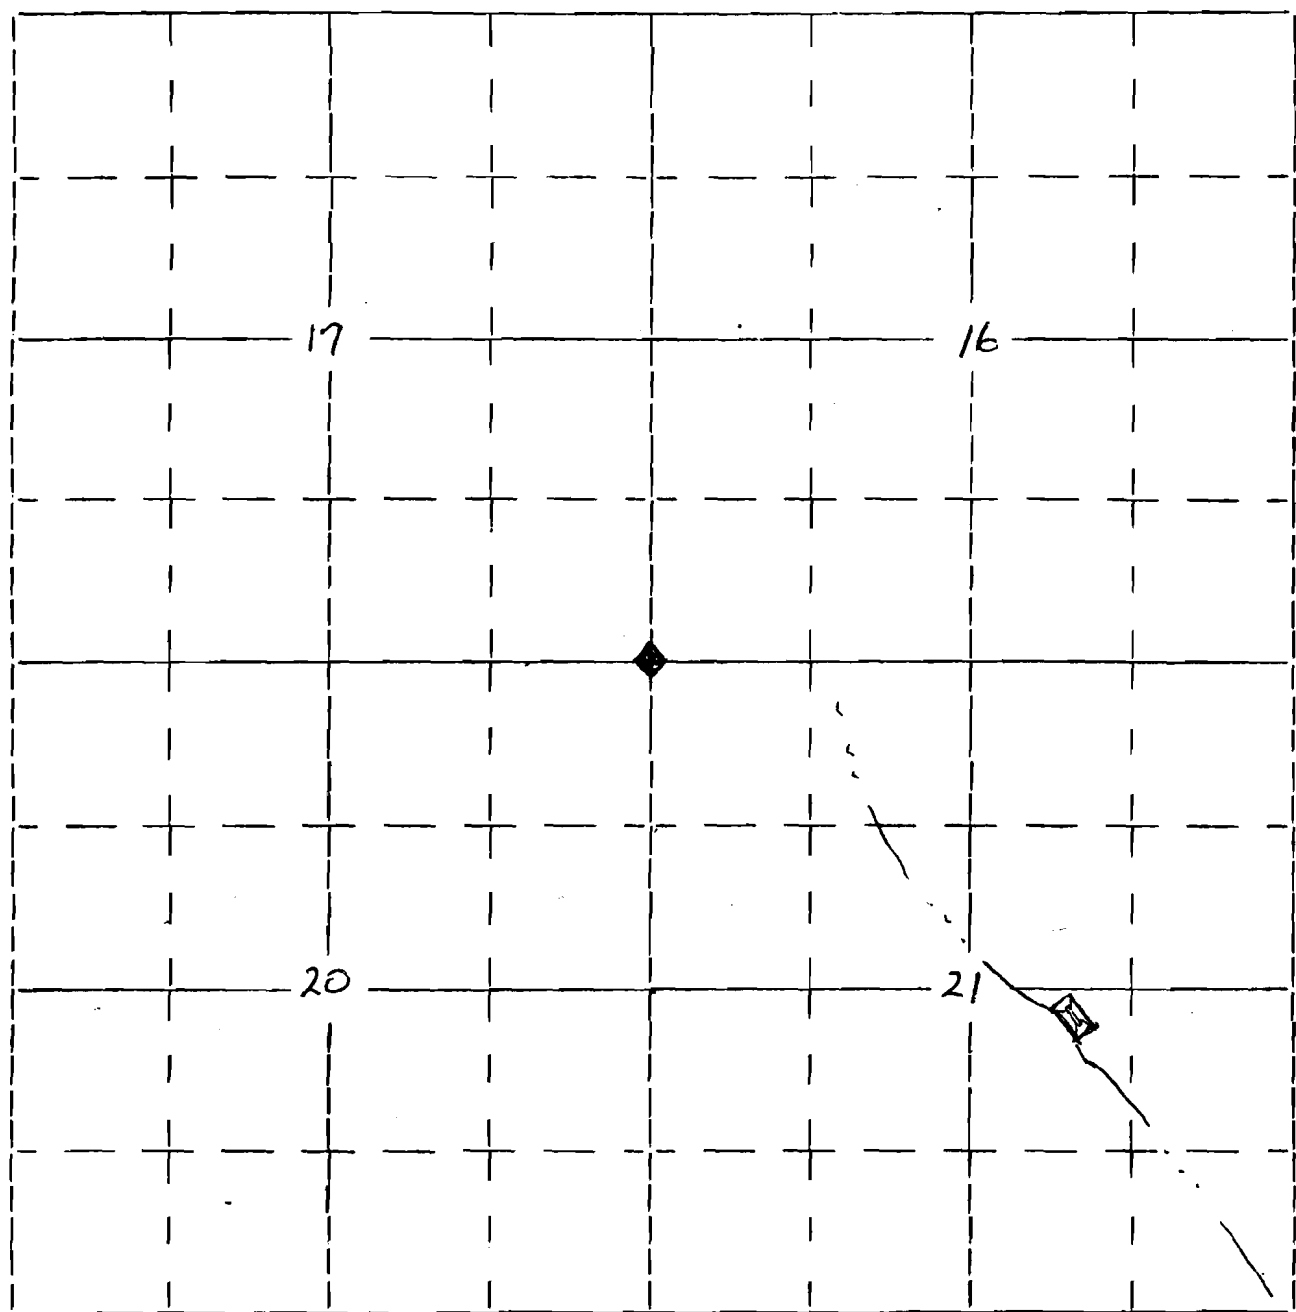

Project is located 3,465' east and 2,805' south of
corner common to sections 16, 17, 20 & 21.