

R-9438
RECEIVED 62580

SEP 2 1983
WATER RESOURCES DEPT.
SALEM, OREGON

Form OR-010-7300-2
4/83

UNITED STATES
DEPARTMENT OF THE INTERIOR
BUREAU OF LAND MANAGEMENT

Section

2, 3, 10 & 11


Township 40 S.

Range 10 E.

Will. Mer.

Appl. No. R-65862

Permit No. R 9438

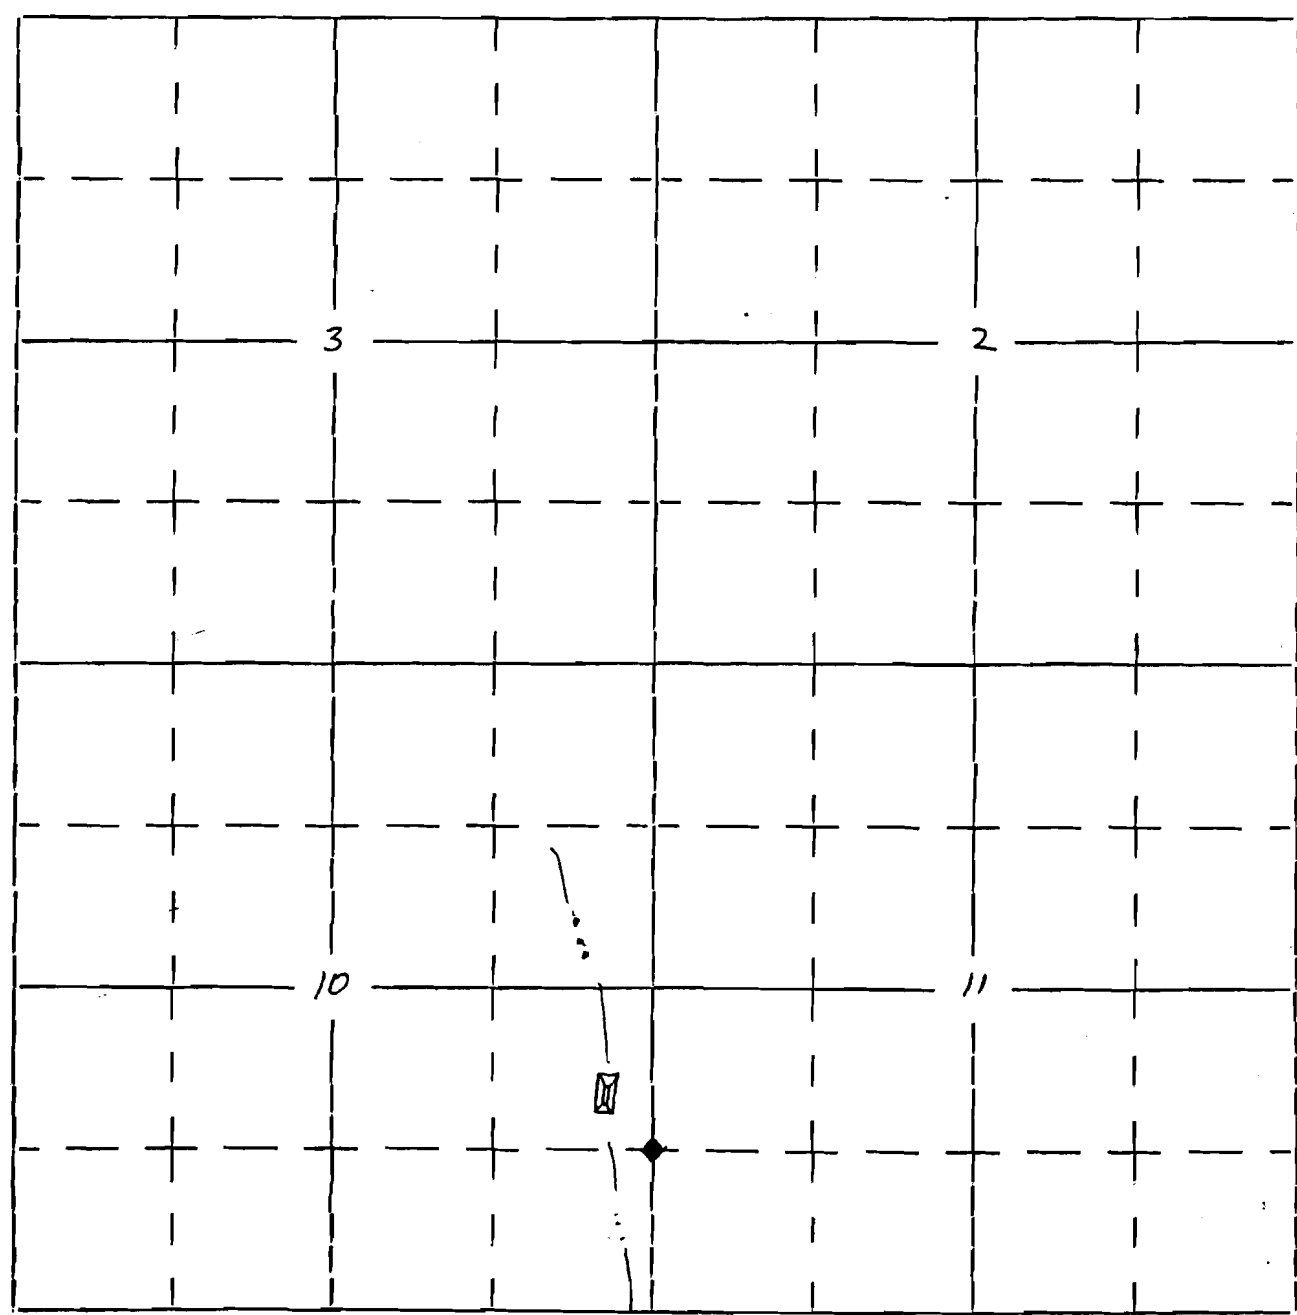

Project is located 344' North and 250' west of the S $\frac{1}{16}$ corner between sections 10 & 11.