

R-9439
62581

RECEIVED

SEP 2 1983

WATER RESOURCES DEPT.
SALEM, OREGON

Form OR-010-7300-2
4/83

UNITED STATES
DEPARTMENT OF THE INTERIOR
BUREAU OF LAND MANAGEMENT

Section


Township 40, 41 S.

Appl. No. R-65863

Range 14, 14 1/2 E.

Permit No. R 9439

Will. Mer.

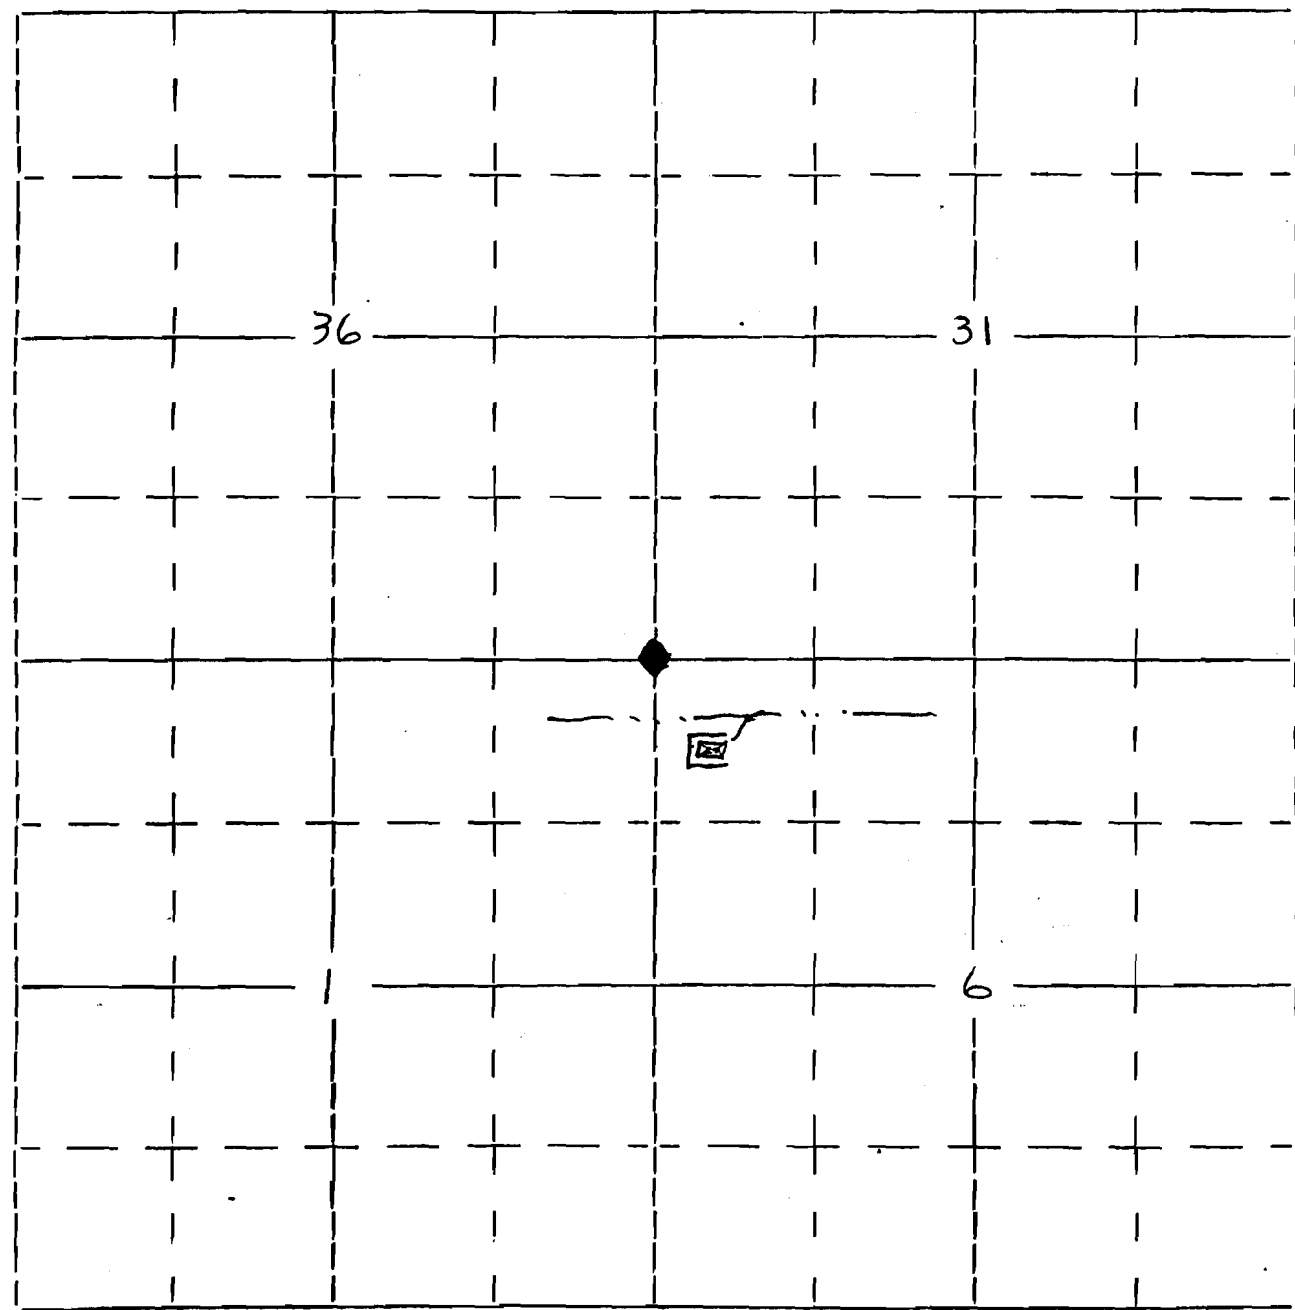

Waterhole is located 686' south and 317' East of corner
Common to sections 36, 1, 6 & 31.