

R-9440
RECEIVED 62582

SEP 2 1983
WATER RESOURCES DEPT.
SALEM, OREGON

Form OR-010-7300-2
4/83

UNITED STATES
DEPARTMENT OF THE INTERIOR
BUREAU OF LAND MANAGEMENT

Section

26, 27, 34 & 35


Township 39 S

Range 13 E

Appl. No. R-65864

Permit No. **R 9440**

Will. Mer.

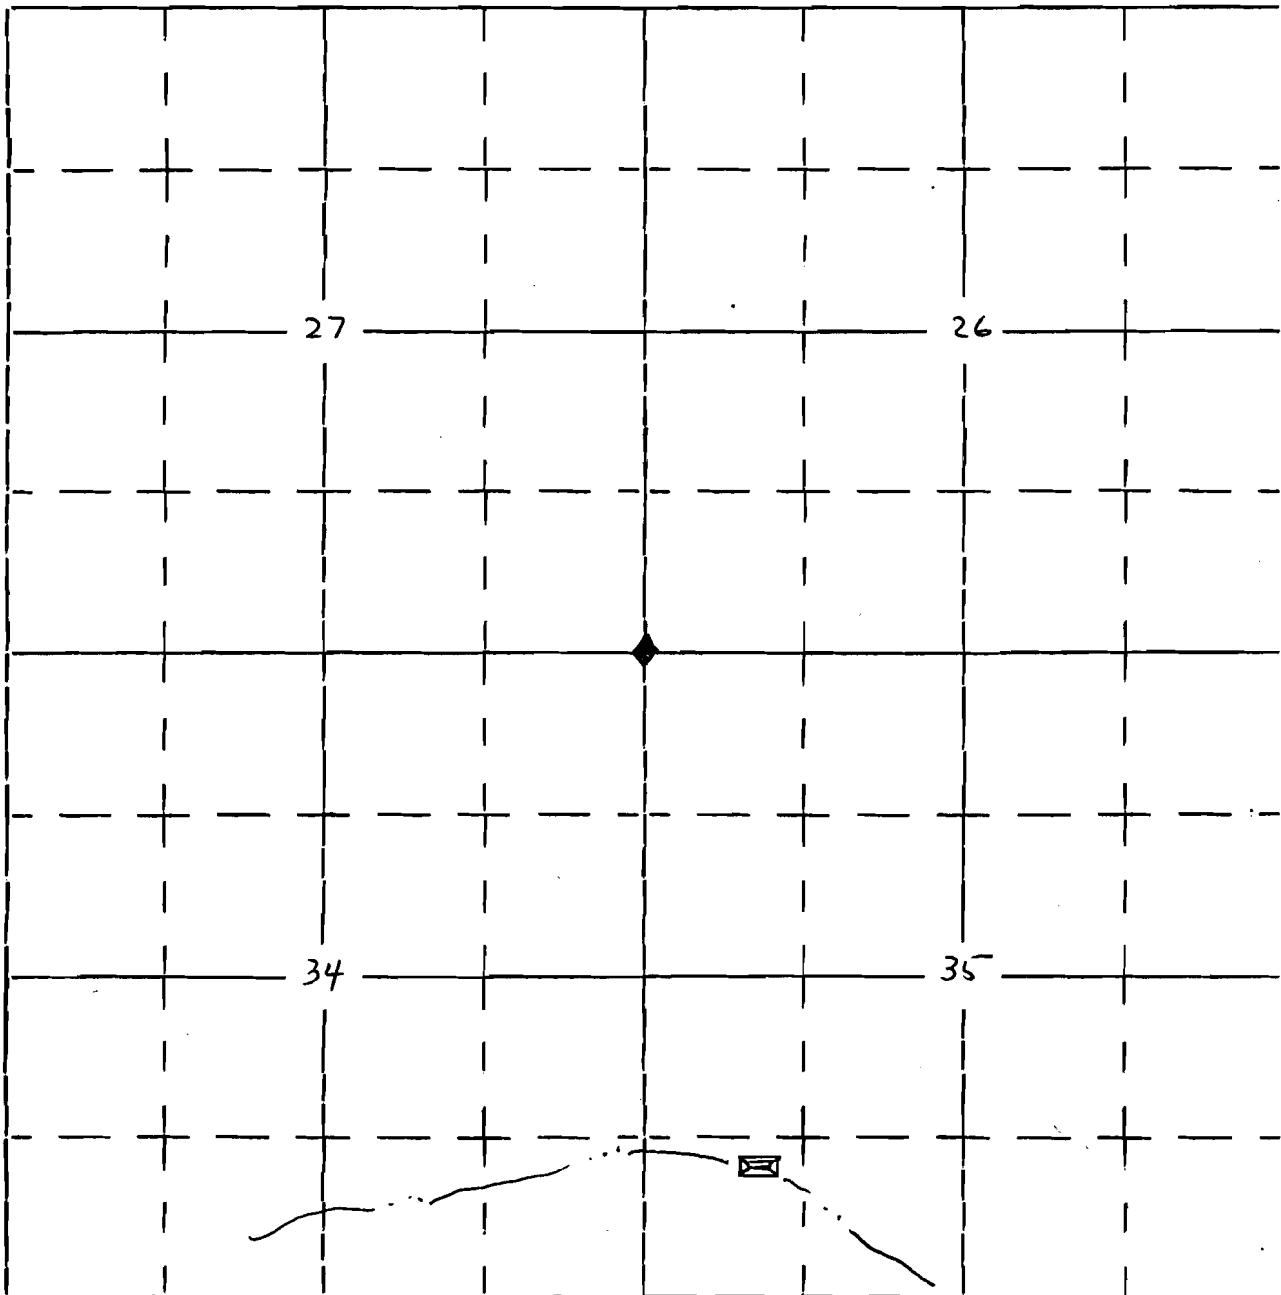

Project is 4620' south and 1,155' east of corner common to sections 26, 27, 34 & 35.