

R-9441
RECEIVED 62583

SEP 2 1983
WATER RESOURCES DEPT.
SALEM, OREGON

Form OR-010-7300-2
4/83

UNITED STATES
DEPARTMENT OF THE INTERIOR
BUREAU OF LAND MANAGEMENT

Section

Township 39S.


Appl. No. R-65865

23, 24, 25 & 26

Range 14E.

Permit No. R 9441

Will. Mer.

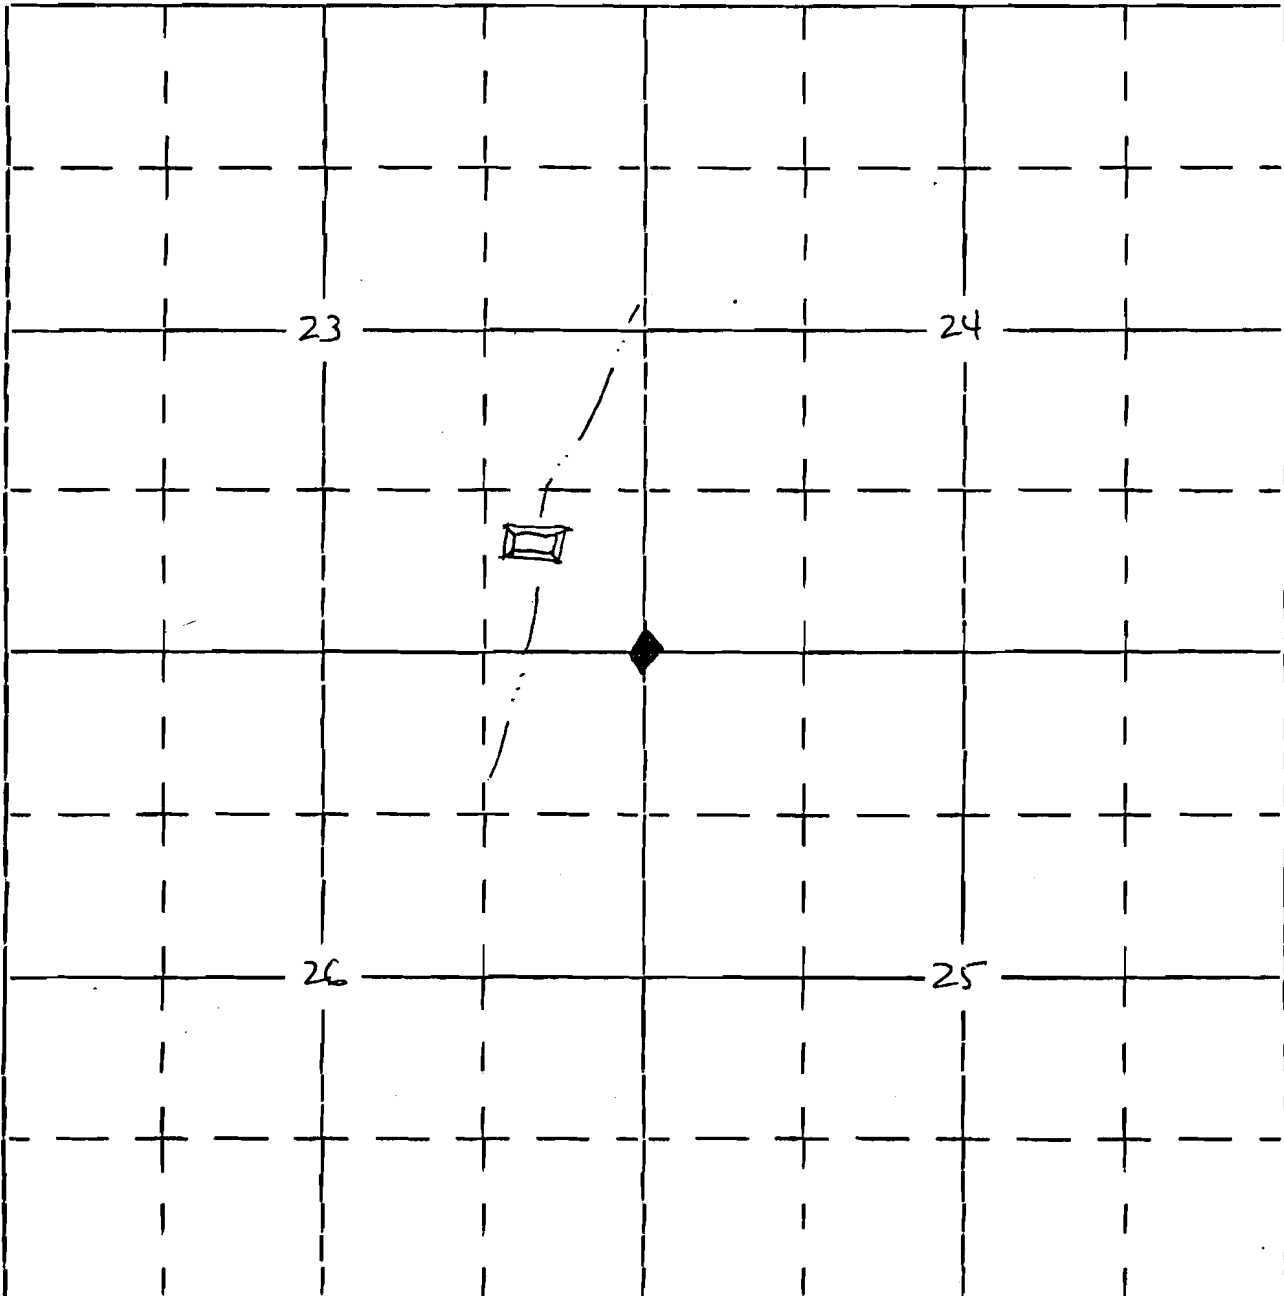

Project is located 906' west and 906' north of corner common
to sections 23, 24, 25 & 26.