

RECEIVED
SEP 2 1983
WATER RESOURCES DEPT.
SALEM, OREGON
R-9442
62584

Form OR-010-7300-2
4/83

UNITED STATES
DEPARTMENT OF THE INTERIOR
BUREAU OF LAND MANAGEMENT

Section

Township 39 S


Appl. No. R-65866

25, 26, 35 & 36

Range 14 E

Permit No. R 9442

Will. Mer.

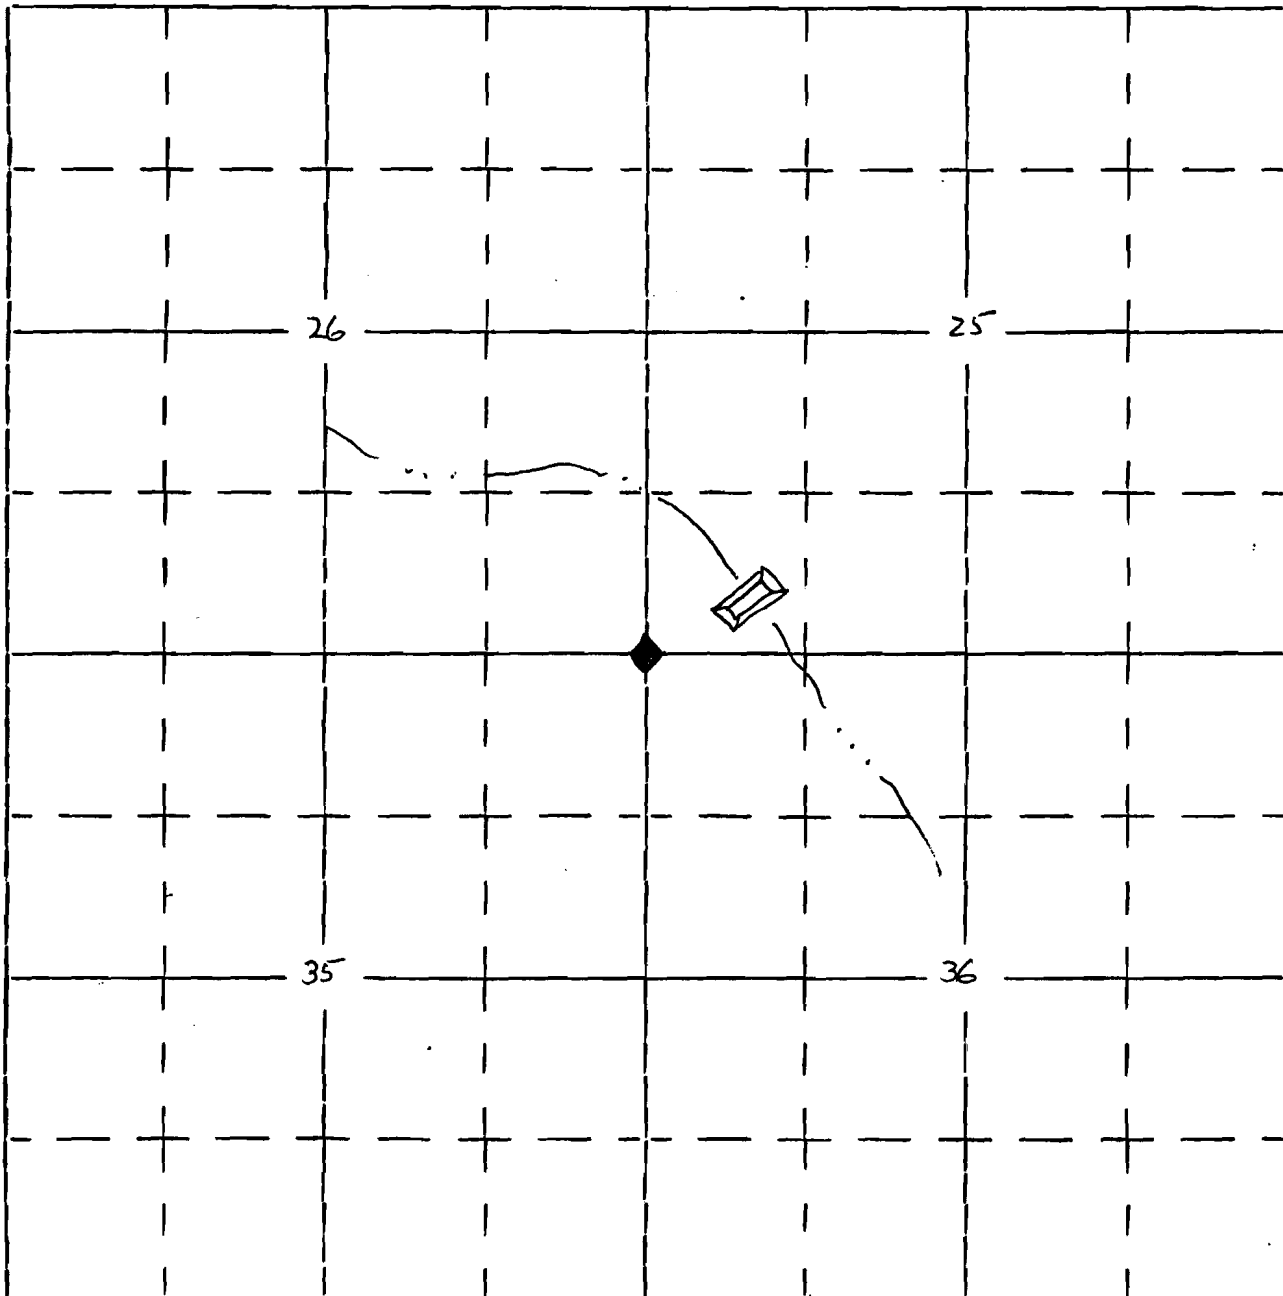

Project is located 1,125' east and 719' north of corner common
to sections 25, 26, 35 & 36.