

RECEIVED ^{R-9443}
62585

SEP 2 1983

WATER RESOURCES DEPT.
SALEM, OREGON

Form OR-010-7300-2
4/83

UNITED STATES
DEPARTMENT OF THE INTERIOR
BUREAU OF LAND MANAGEMENT

Section

Township 39 S.


Appl. No. R-65867

14, 15, 22, & 23

Range 14 E.

Permit No. R 9443

Will. Mer.

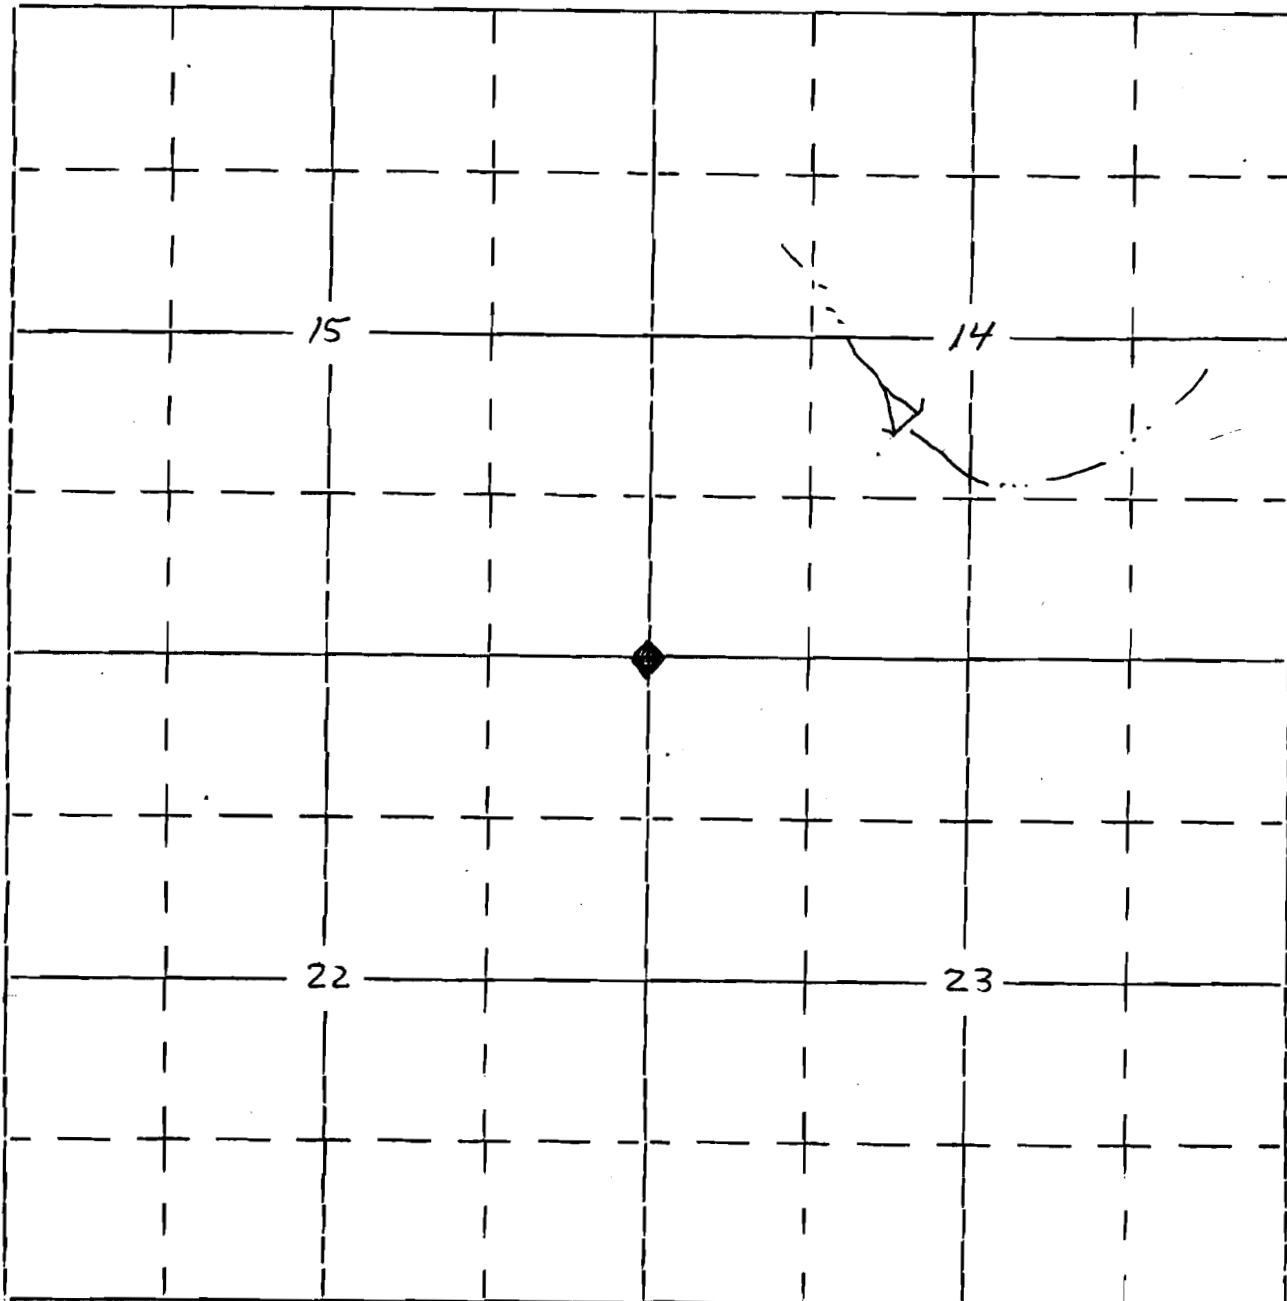

Project is located 2,475' east and 2,145' north of corner
Common to sections 14, 15, 22 & 23.