

R-9444
62586

RECEIVED

SEP 2 1983

Form OR-010-7300-2
4/83

UNITED STATES
DEPARTMENT OF THE INTERIOR
BUREAU OF LAND MANAGEMENT

WATER RESOURCES DEPT.
SALEM, OREGON

Section

Township 39 S.


Appl. No. R-65868

3, 4, 9 & 10

Range 14 E.

Permit No. R 9444

Will. Mer.

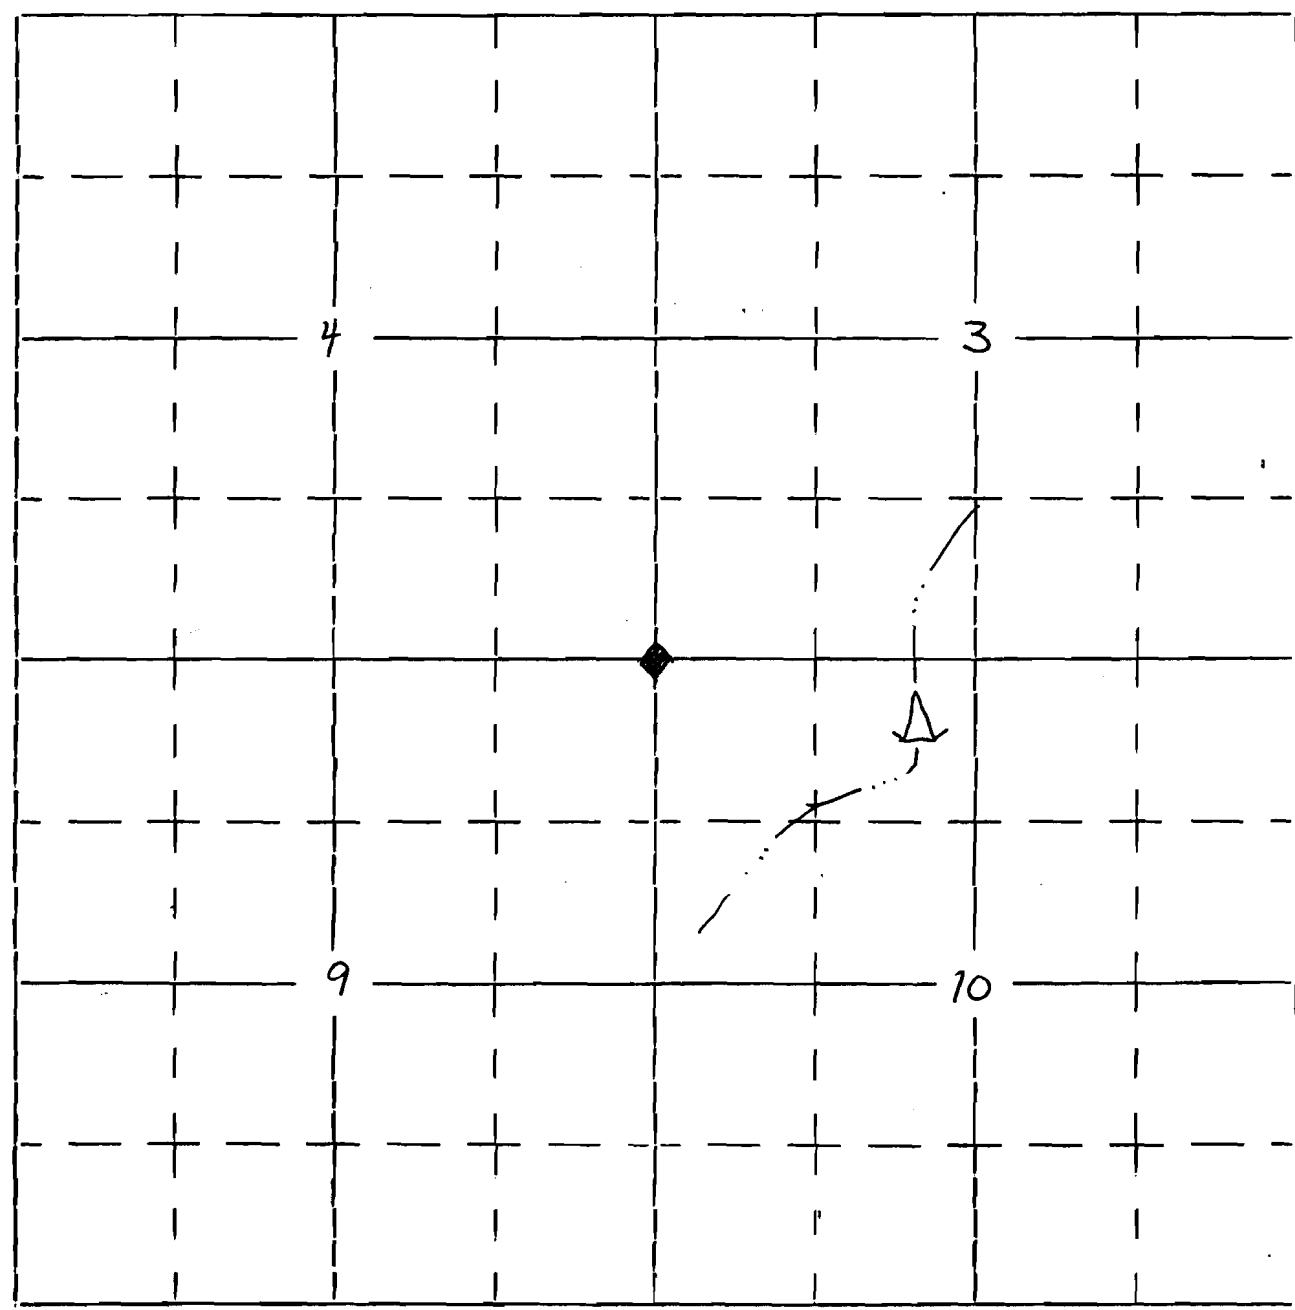

Project is 2,499' east and 594' south of corner common
to sections 3, 4, 9 & 10.