

RECEIVED R-9447
62589

SEP 2 1983

WATER RESOURCES DEPT.
SALEM, OREGON

Form OR-010-7300-2
4/83

UNITED STATES
DEPARTMENT OF THE INTERIOR
BUREAU OF LAND MANAGEMENT

Section

Township 40 S.


Appl. No. R-65871

1, 2, 11, 12

Range 10 E.

Permit No. R 9447

Will. Mer.

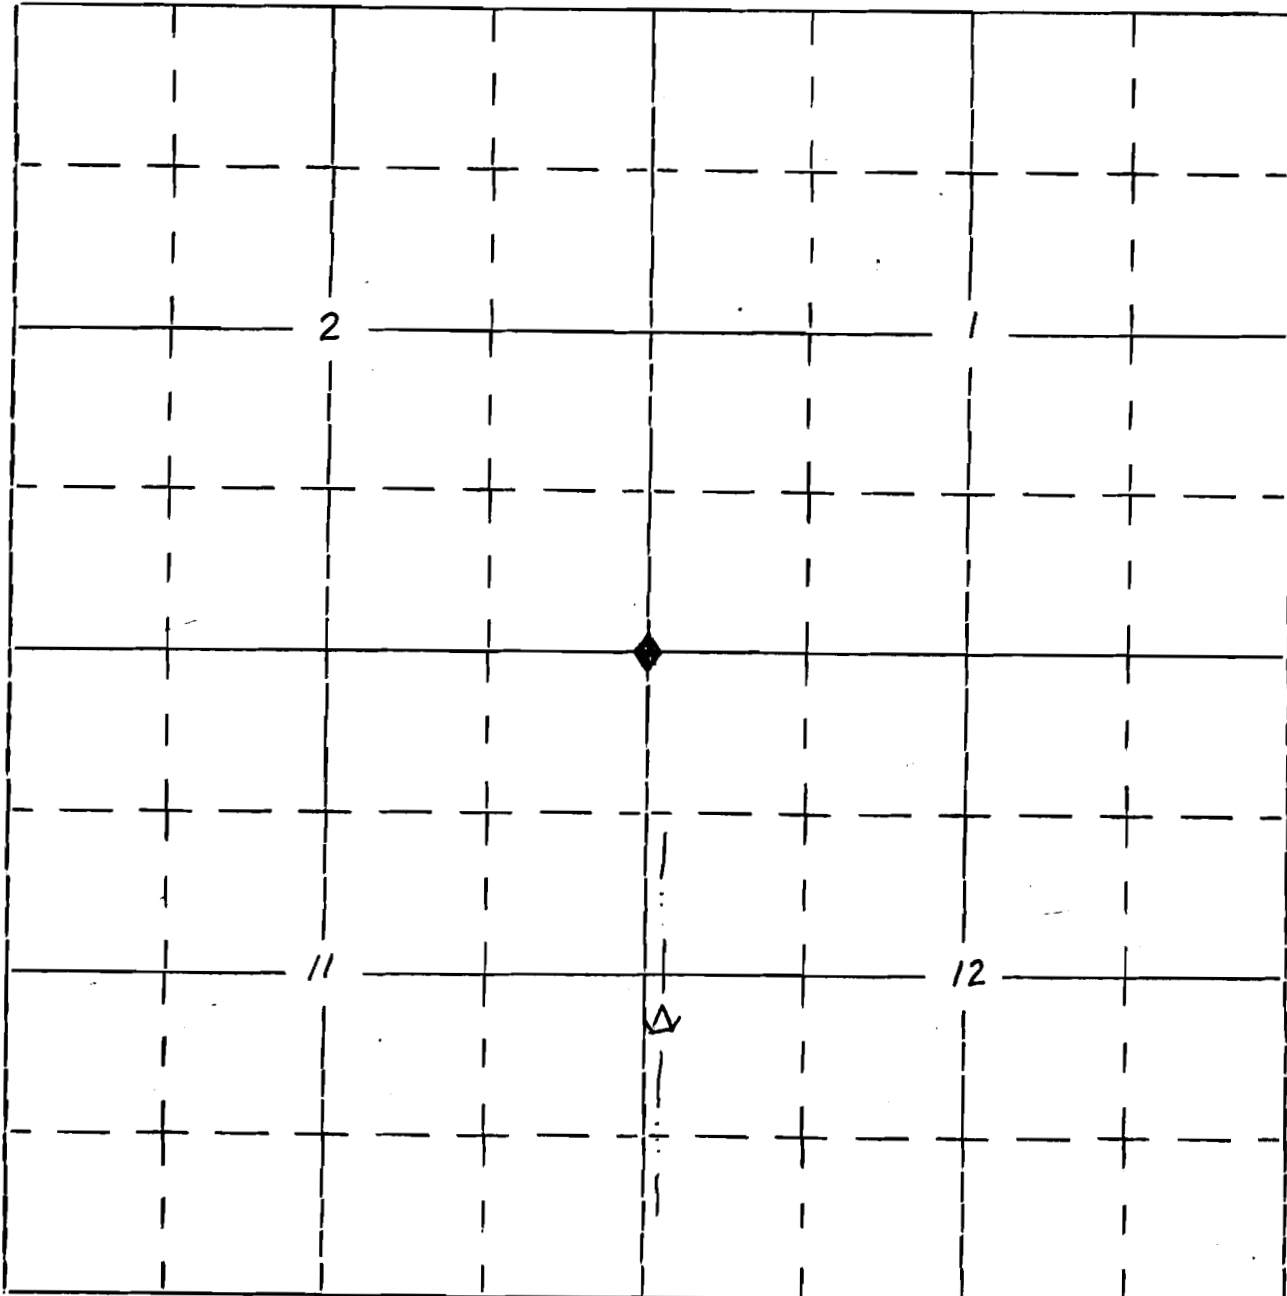

Location of project is 3,307' south and 58' east of corner common
to sections 1, 2, 11 & 12.