

R-9448  
**RECEIVED** 62590

SEP 2 1983  
WATER RESOURCES DEPT.  
SALEM, OREGON


Form OR-010-7300-2  
4/83

UNITED STATES  
DEPARTMENT OF THE INTERIOR  
BUREAU OF LAND MANAGEMENT

Section  
\_\_\_\_\_  
1, 2, 11 & 12  
\_\_\_\_\_

Township 39 S.  
Range 14 E.  
Will. Mer.

Appl. No. R-65872  
Permit No. R 9448

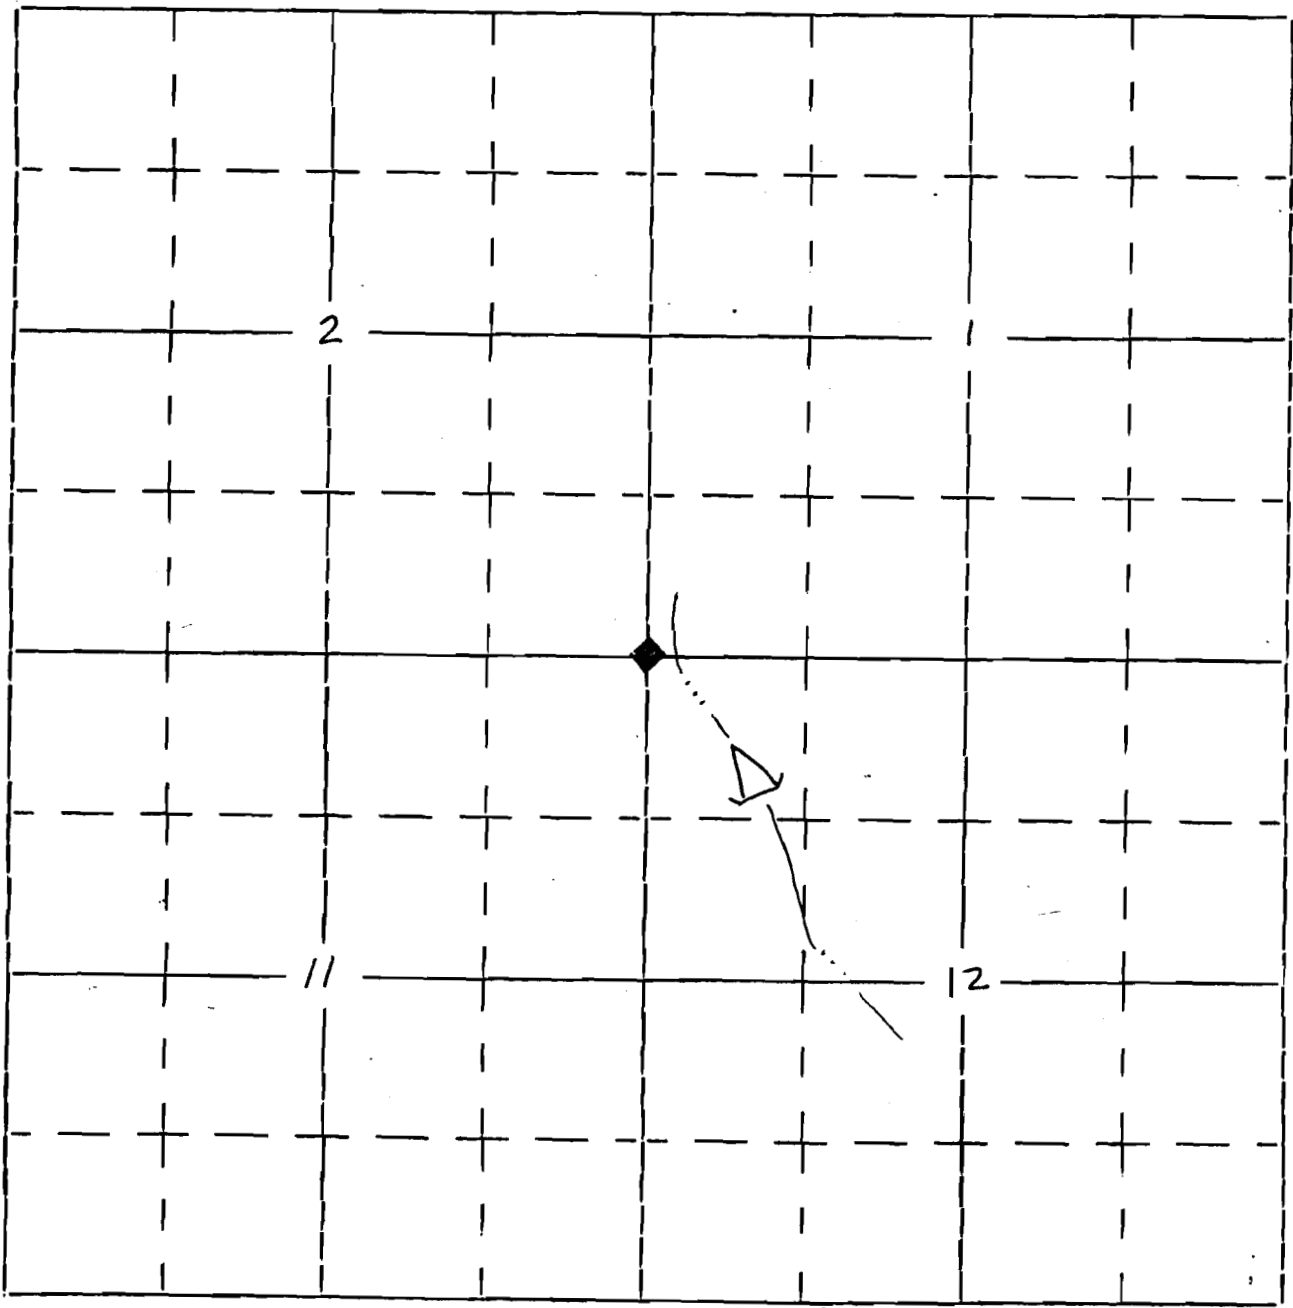

Project is located 990' south and 660' east of corner common  
to sections 1, 2, 11 & 12.