

RECEIVED R-9449
62591

SEP 2 1983

WATER RESOURCES DEPT.
SALEM, OREGON

Form OR-010-7300-2
4/83

UNITED STATES
DEPARTMENT OF THE INTERIOR
BUREAU OF LAND MANAGEMENT

Section

Township 39 S.


Appl. No. R-65873

26, 27, 34 & 35

Range 14 E.

Permit No. R 9449

Will. Mer.

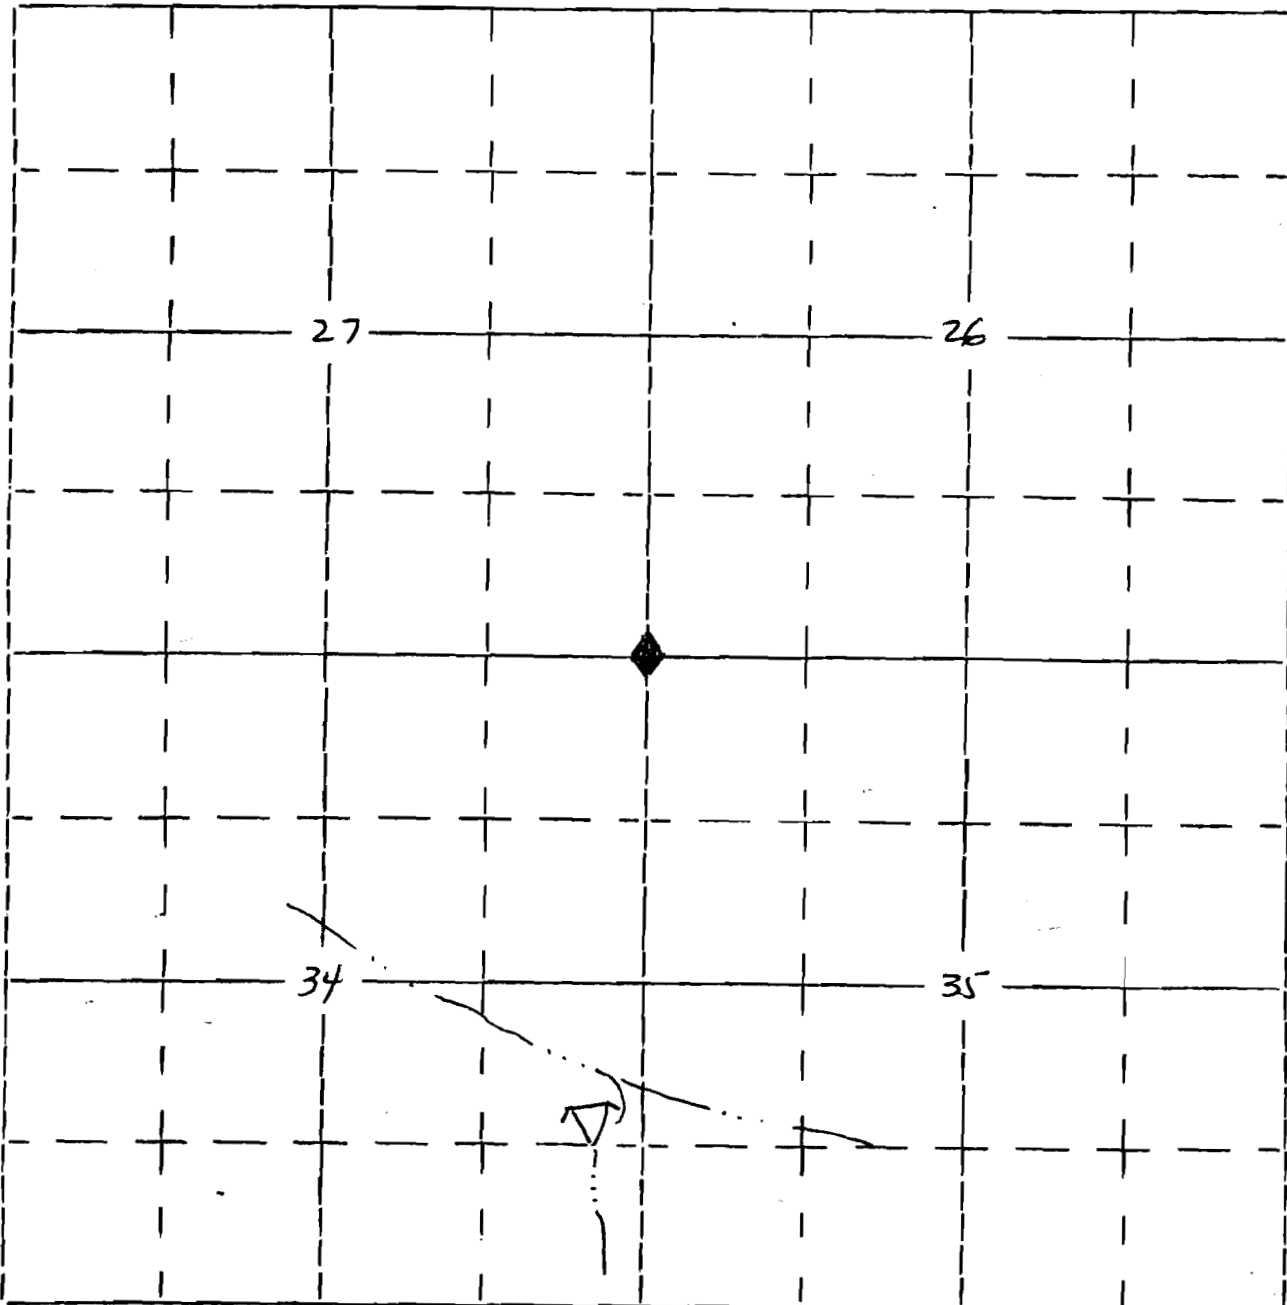

Project is located 3,465' south and 660' west of corner common
to sections 26, 27, 34 & 35