

RECEIVED R-9450
62592
SEP 2 1980
WATER RESOURCES DEPT.
SALEM, OREGON

Form OR-010-7300-2
4/83

UNITED STATES
DEPARTMENT OF THE INTERIOR
BUREAU OF LAND MANAGEMENT

Section

Township 38 & 39 S.


Appl. No. R-65874

34, 35, 2 & 3

Range 14 E.

Permit No. R 9450

Will. Mer.

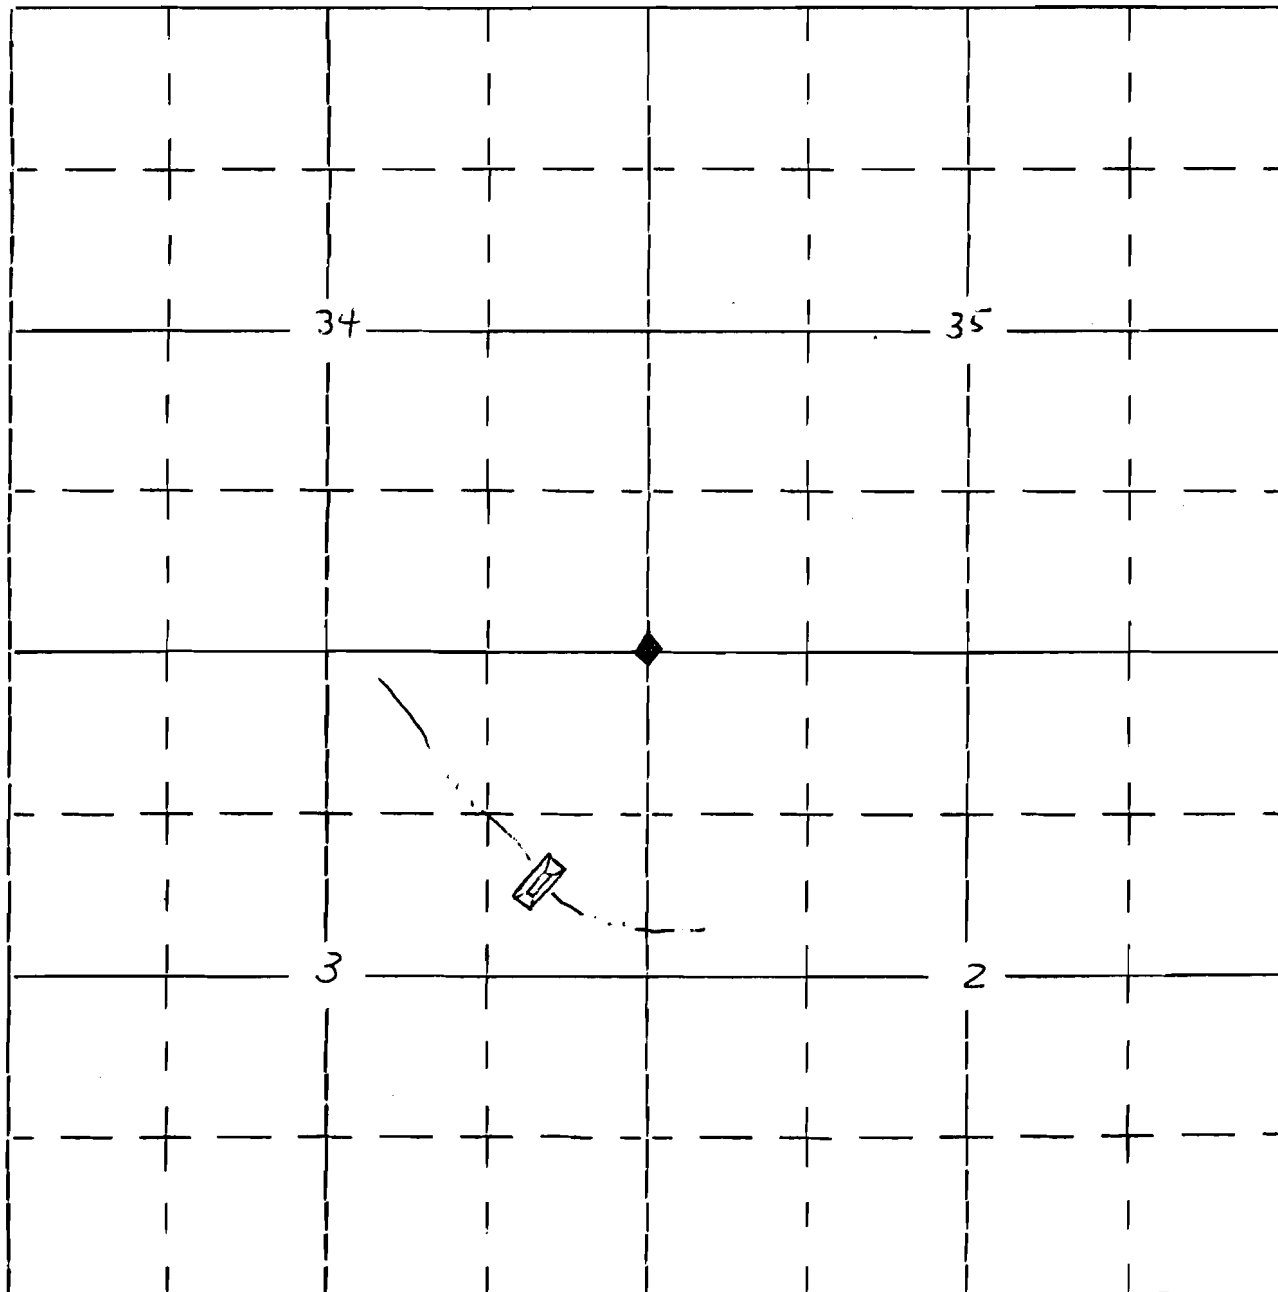

Project is located 1,875' south and 844' west of corner common to sections 34, 35, 2 & 3.