

R-9453
RECEIVED 62595

SEP 2 1982

WATER RESOURCES DEPT.
SALEM, OREGON

Form OR-010-7300-2
4/83

UNITED STATES
DEPARTMENT OF THE INTERIOR
BUREAU OF LAND MANAGEMENT

Section

Township 37 S.


Appl. No. R-65877

26, 27, 34 & 35

Range 11 E.

Permit No. R 9453

Will. Mer.

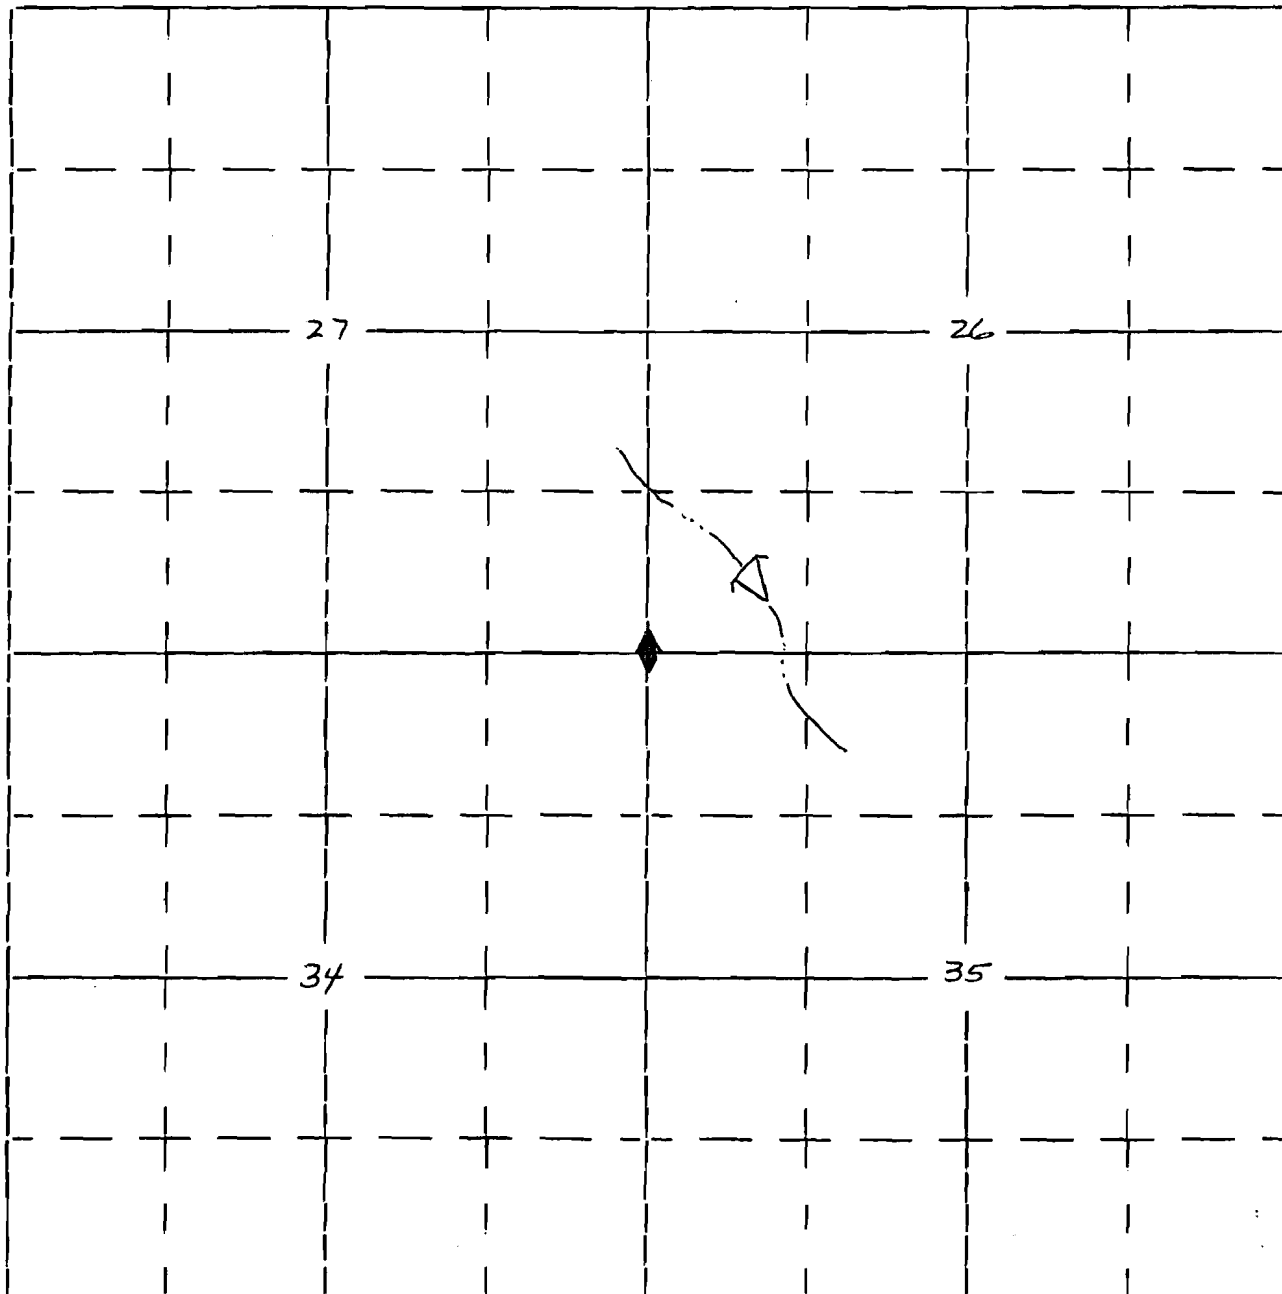

Reservoir located North 495' and East 660' from corner common
to sections 26, 27, 34 & 35.