

R-9454  
62596

RECEIVED

SEP 2 1983

Form OR-010-7300-2  
4/83

UNITED STATES  
DEPARTMENT OF THE INTERIOR  
BUREAU OF LAND MANAGEMENT


WATER RESOURCES DEPT.  
SALEM, OREGON

Section  
10, 11, 14 & 15

Township 37 S.  
Range 14 E.

Appl. No. R-65878  
Permit No. R 9454

Will. Mer.

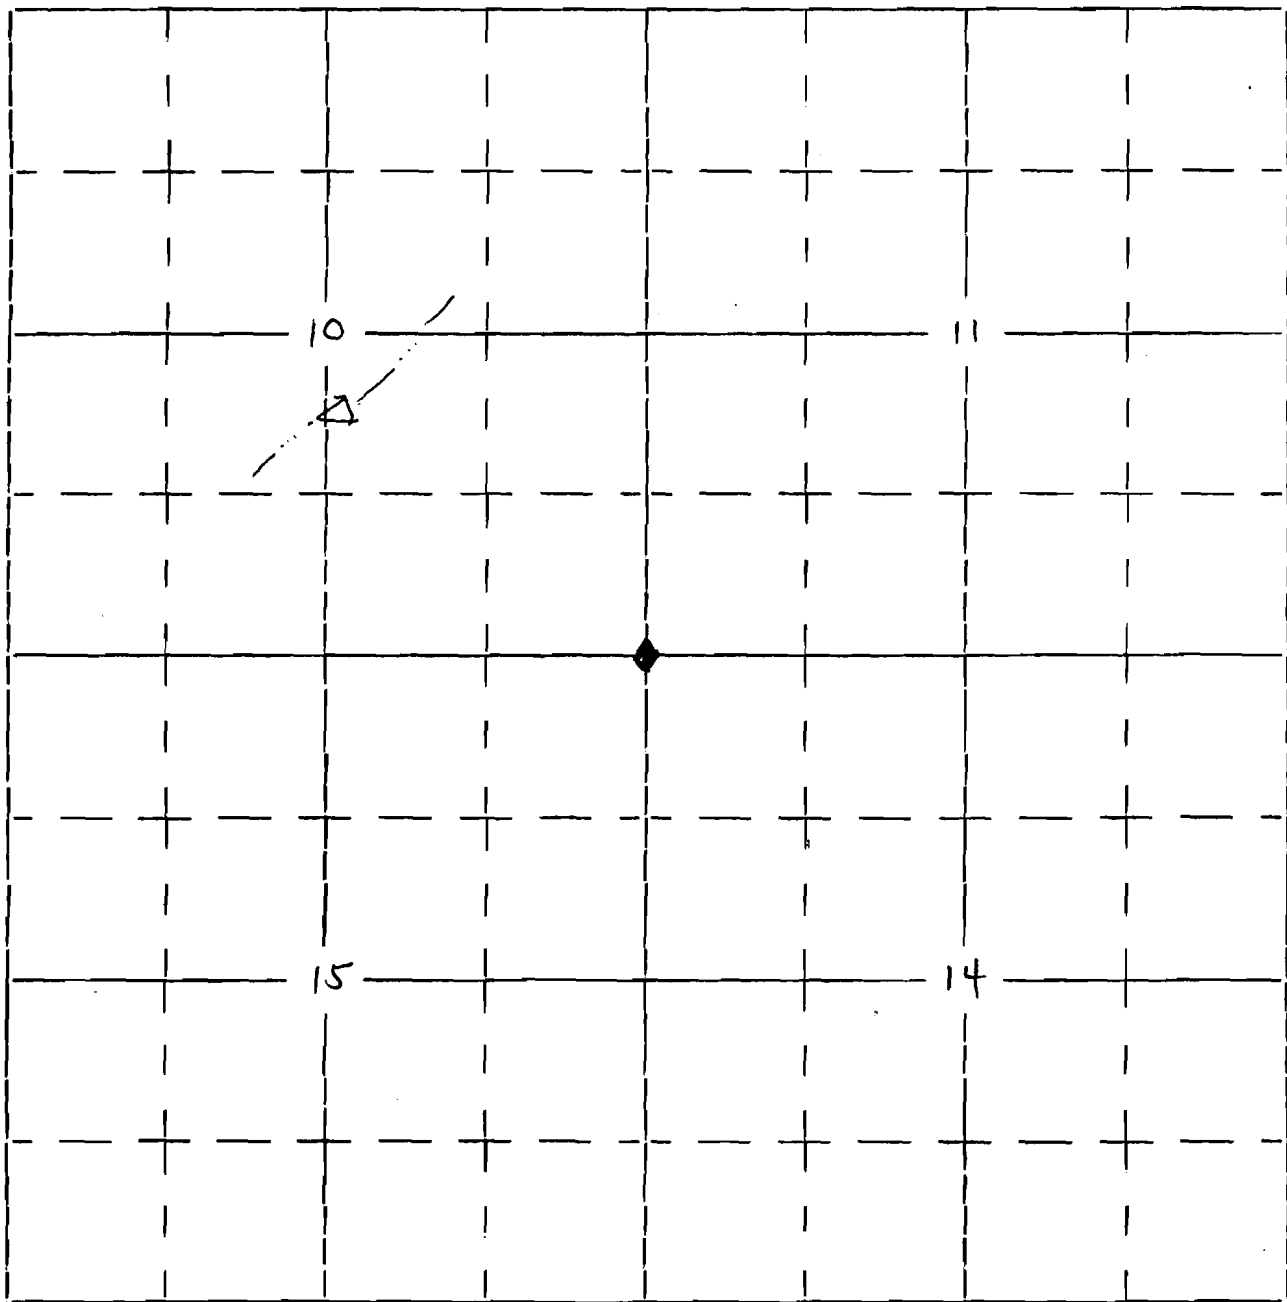

Reservoir is located 2,475' West and 1,815' North of section corner common to 10, 11, 14 & 15.