

R-9455
62597

RECEIVED

SEP 2 1983

WATER RESOURCES DEPT.
SALEM, OREGON

Form OR-010-7300-2
4/83

UNITED STATES
DEPARTMENT OF THE INTERIOR
BUREAU OF LAND MANAGEMENT

Section

Township 37 S.


Appl. No. R-65879

3, 4, 9 & 10

Range 15 E.

Permit No. R 9455

Will. Mer.

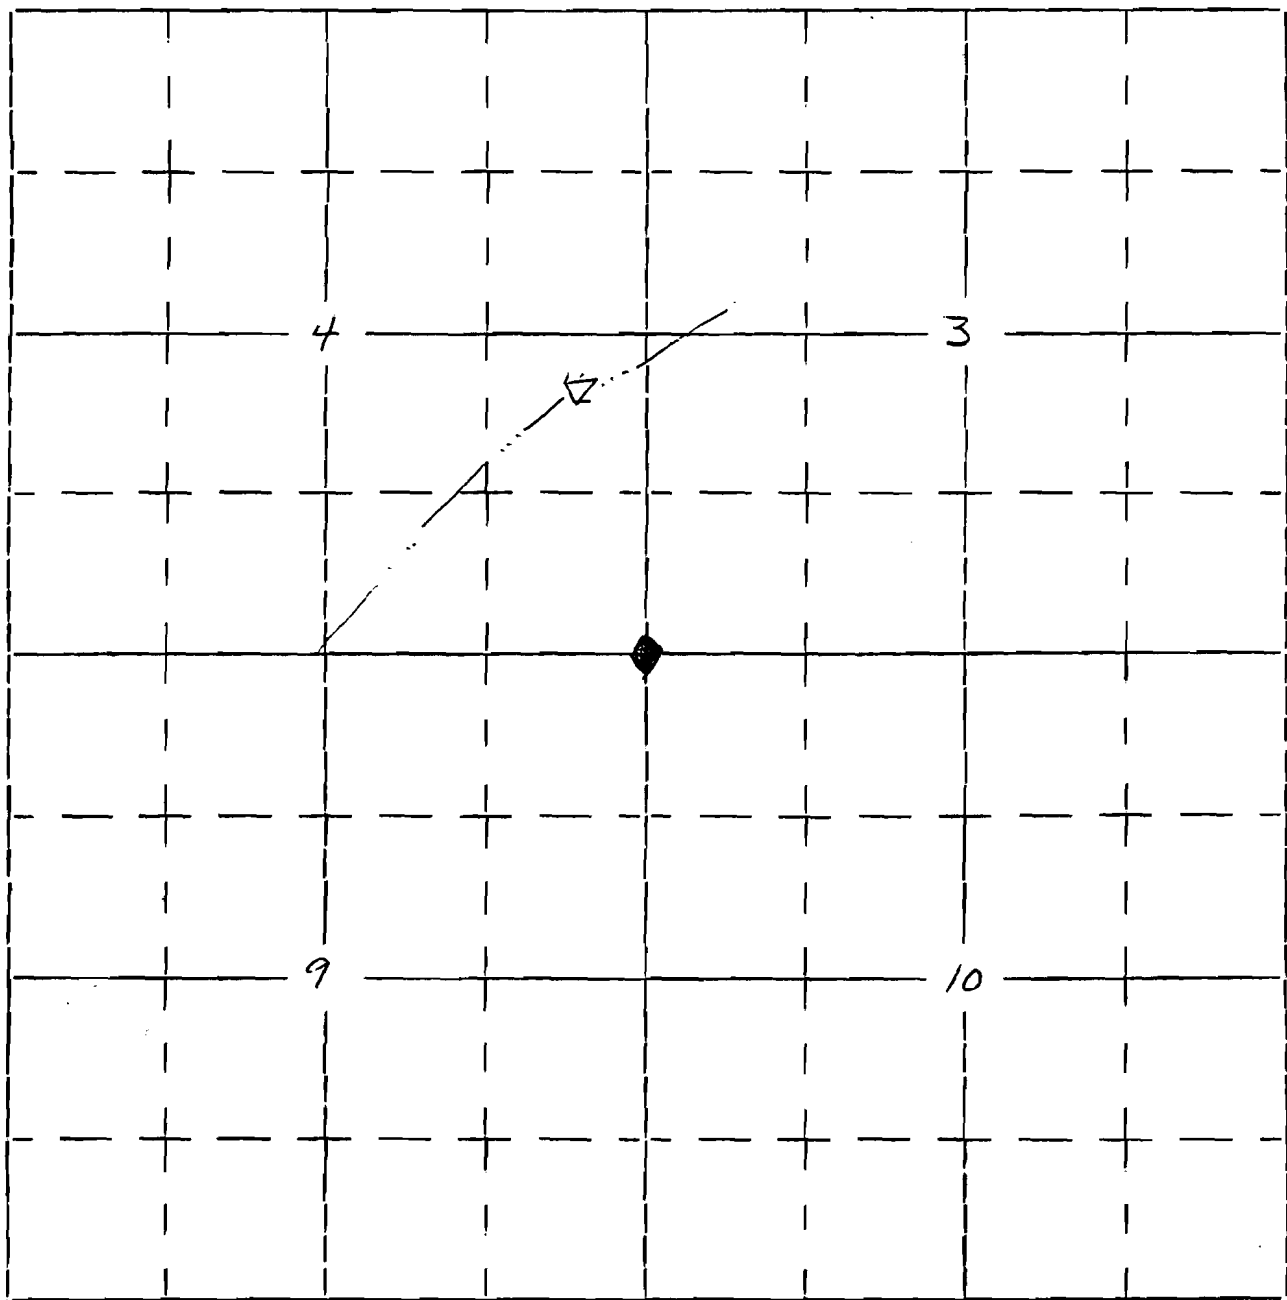

Project is located 1,375' North and 469' West of section corner
common to 3, 4, 9 & 10.