

R-9456
62598

RECEIVED

SEP 2 1983

WATER RESOURCES DEPT.
SALEM, OREGON

Form OR-010-7300-2
4/83

UNITED STATES
DEPARTMENT OF THE INTERIOR
BUREAU OF LAND MANAGEMENT

Section


Township 38 S

Appl. No. R-65880

Range 11 E.

Permit No. R 9456

Will. Mer.

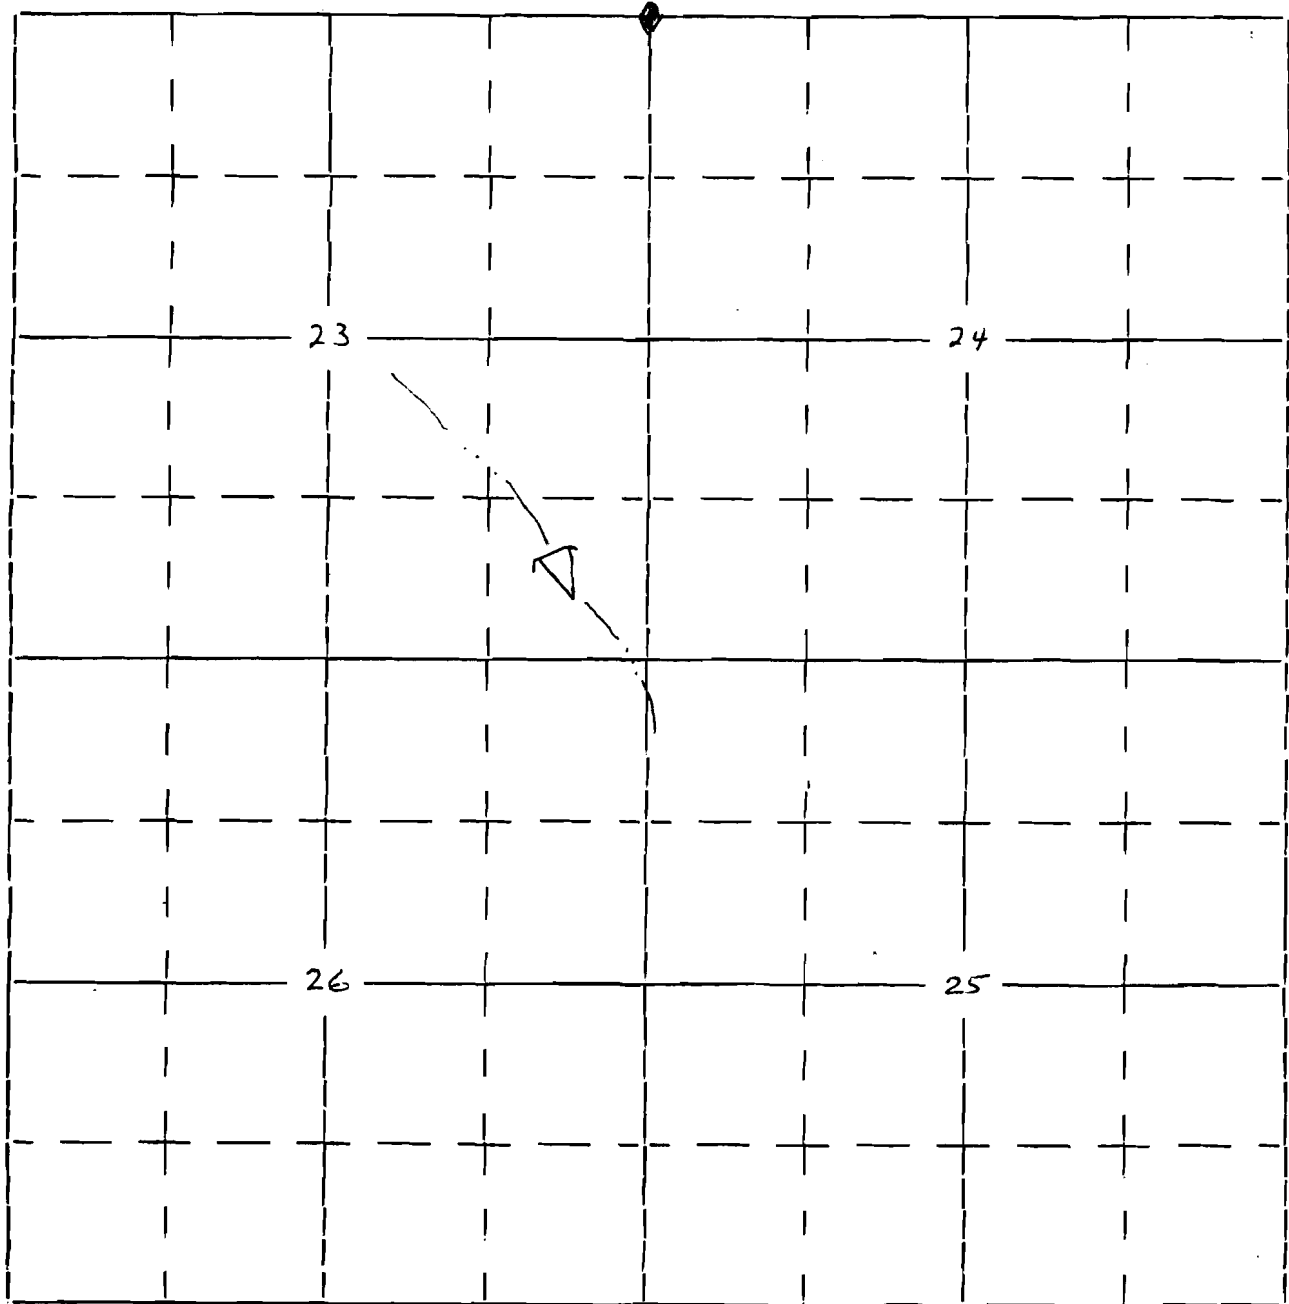

Project is located 4620' South and 660' West of section
corner common to 13, 14, 23 & 24.