

R-9457

RECEIVED 62599

SEP 2 1983

WATER RESOURCES DEPT.
SALEM, OREGON

Form OR-010-7300-2
4/83

UNITED STATES
DEPARTMENT OF THE INTERIOR
BUREAU OF LAND MANAGEMENT

Section
25, 26, 35 & 36


Township 38 S.

Appl. No. R-65881

Range 13 E.

Permit No. R 9457

Will. Mer.

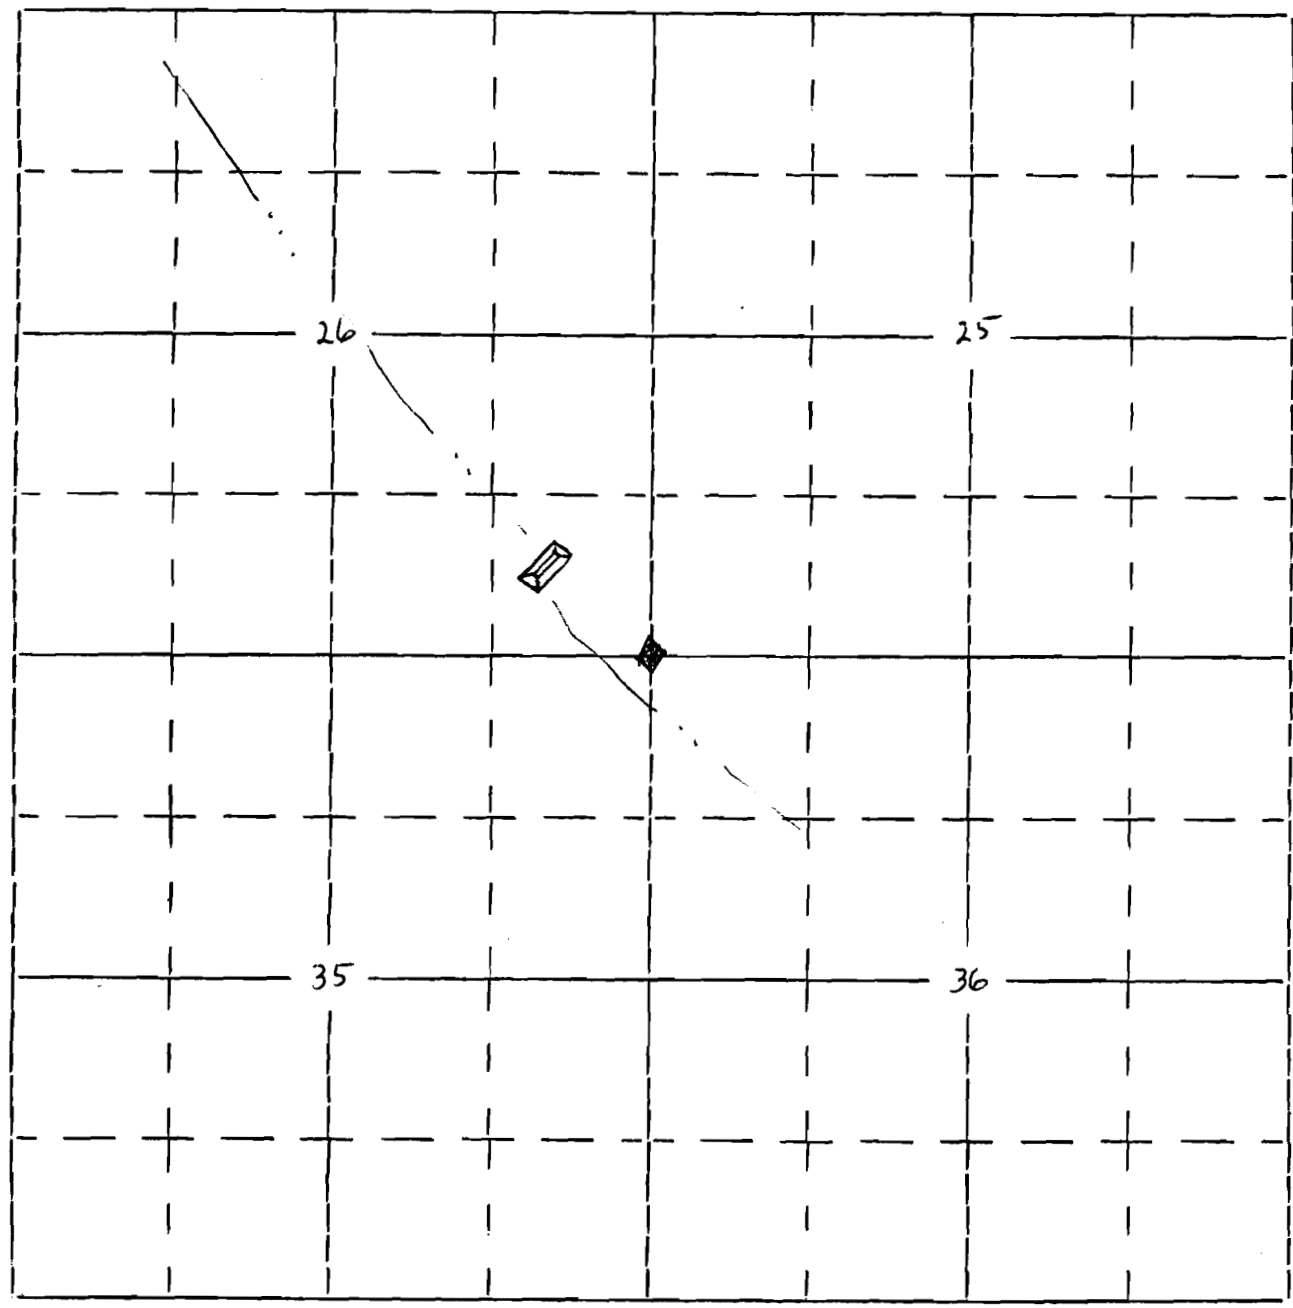

Project is located 750' West and 562' North of corner common to sections 25, 26, 35 & 36.