

Form OR-010-7300-2
4/83

UNITED STATES
DEPARTMENT OF THE INTERIOR
BUREAU OF LAND MANAGEMENT

RECEIVED R-9459
62601

SEP 2 1982
WATER RESOURCES DEPT.
SALEM, OREGON

Section

20, 21, 28 & 29


Township 39 S.

Range 11 E.

Appl. No. R-65883

Permit No. R 9459

Will. Mer.

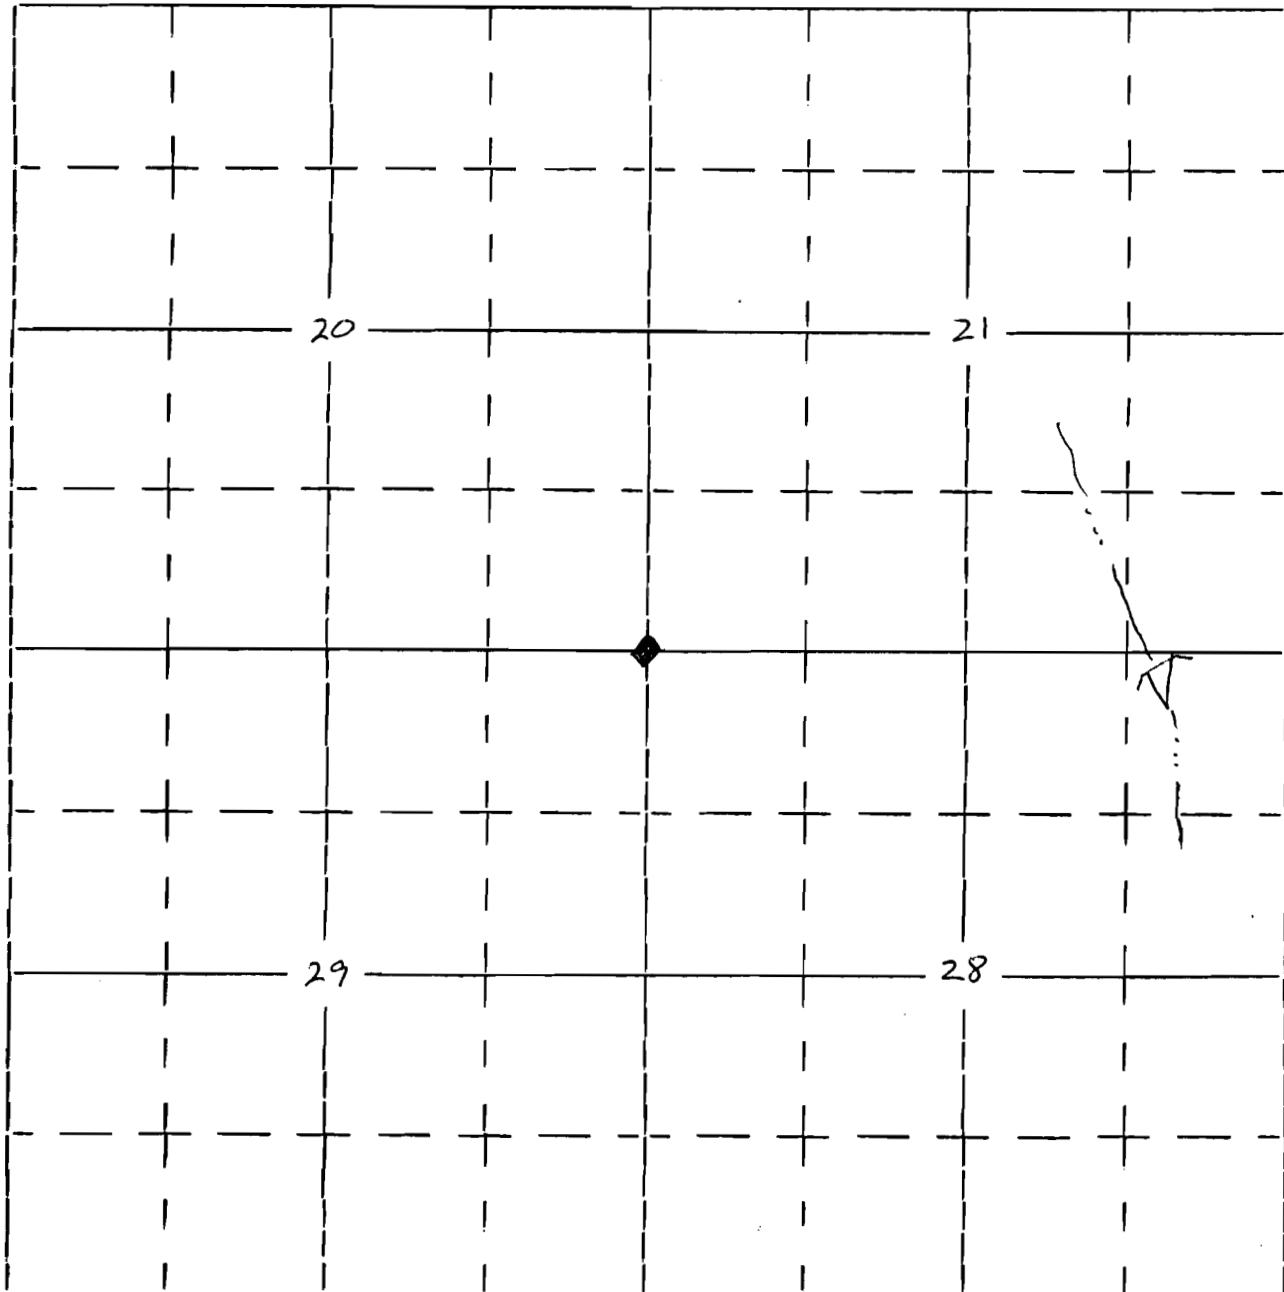

Project is located 4,062' east and 344' south of corner common to sections 20, 21, 28 & 29.