

R-9460
62602

RECEIVED

SEP 2 1983

Form OR-010-7300-2
4/83


UNITED STATES
DEPARTMENT OF THE INTERIOR
BUREAU OF LAND MANAGEMENT

MINERAL RESOURCES DEPT.
SALEM, OREGON

Section
23, 24, 25 & 26

Township 39 S.
Range 13 E.
Will. Mer.

Appl. No. R-65884
Permit No. R 9460

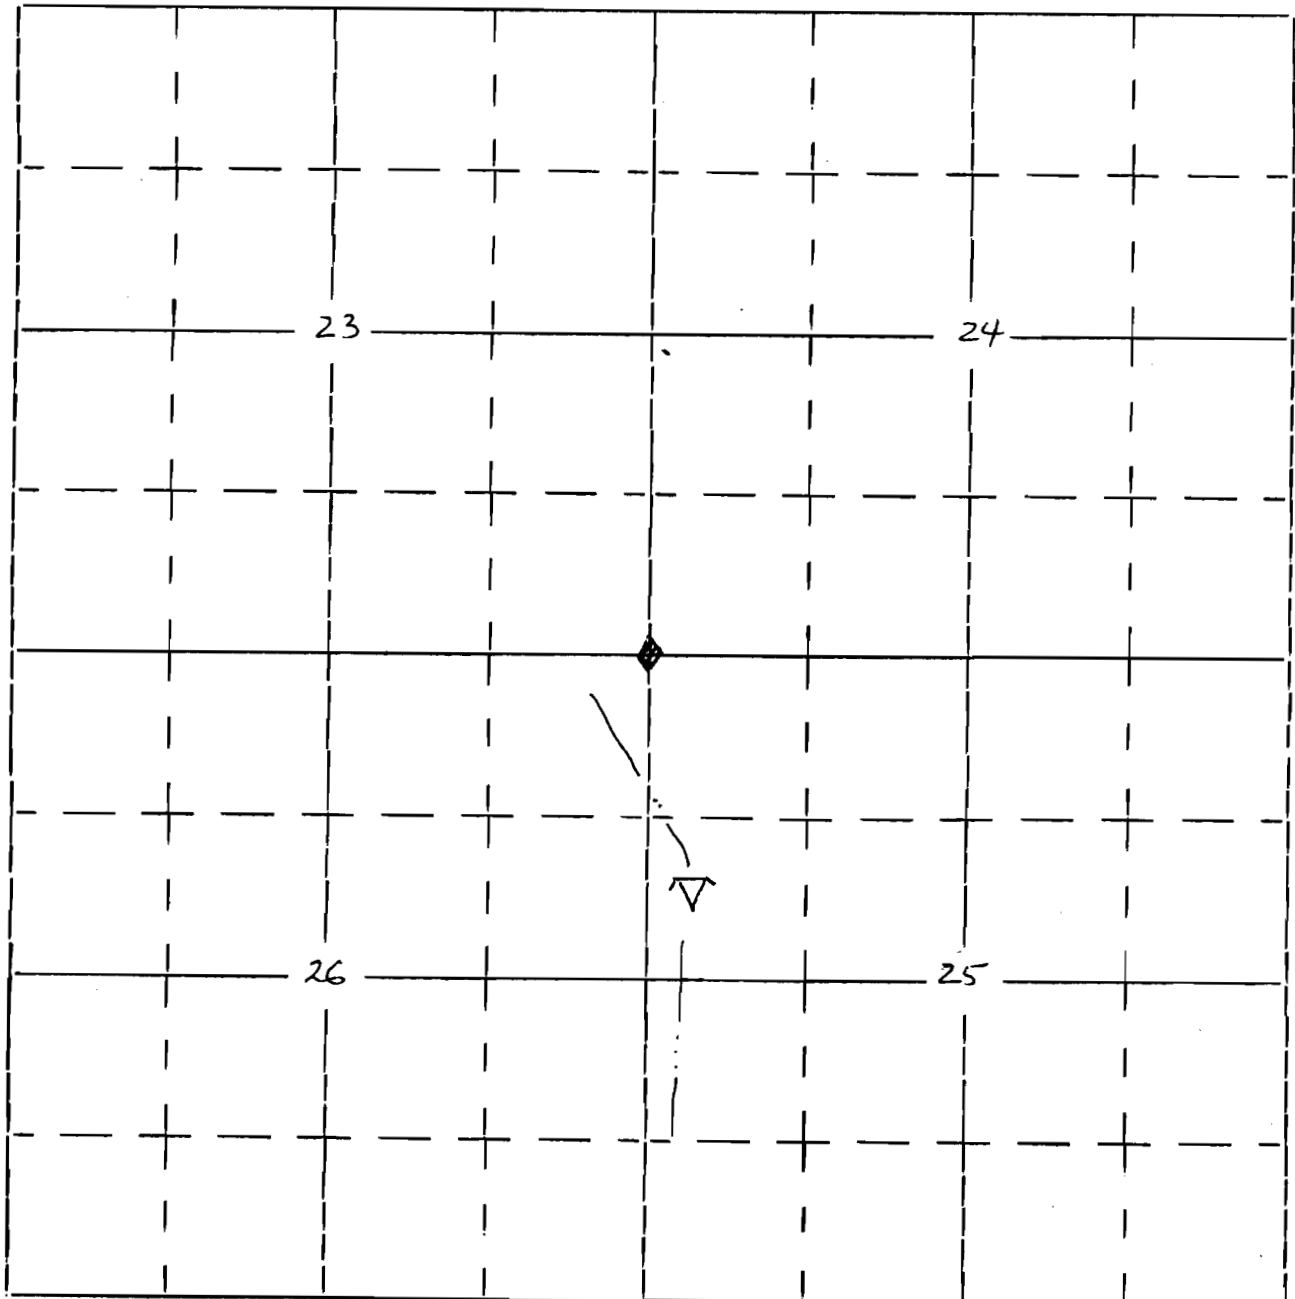

Project is south 1,980' and east 330' from corner common to
Sections 23, 24, 25 & 26.