

RECEIVED R-9461
62603

Form OR-010-7300-2
4/83

UNITED STATES
DEPARTMENT OF THE INTERIOR
BUREAU OF LAND MANAGEMENT

SEP 2 1983
WATER RESOURCES DEPT.
SALEM, OREGON

Section

14, 15, 22 & 23


Township 39 S

Range 14 E

Appl. No. R-65885

Permit No. R 9461

Will. Mer.

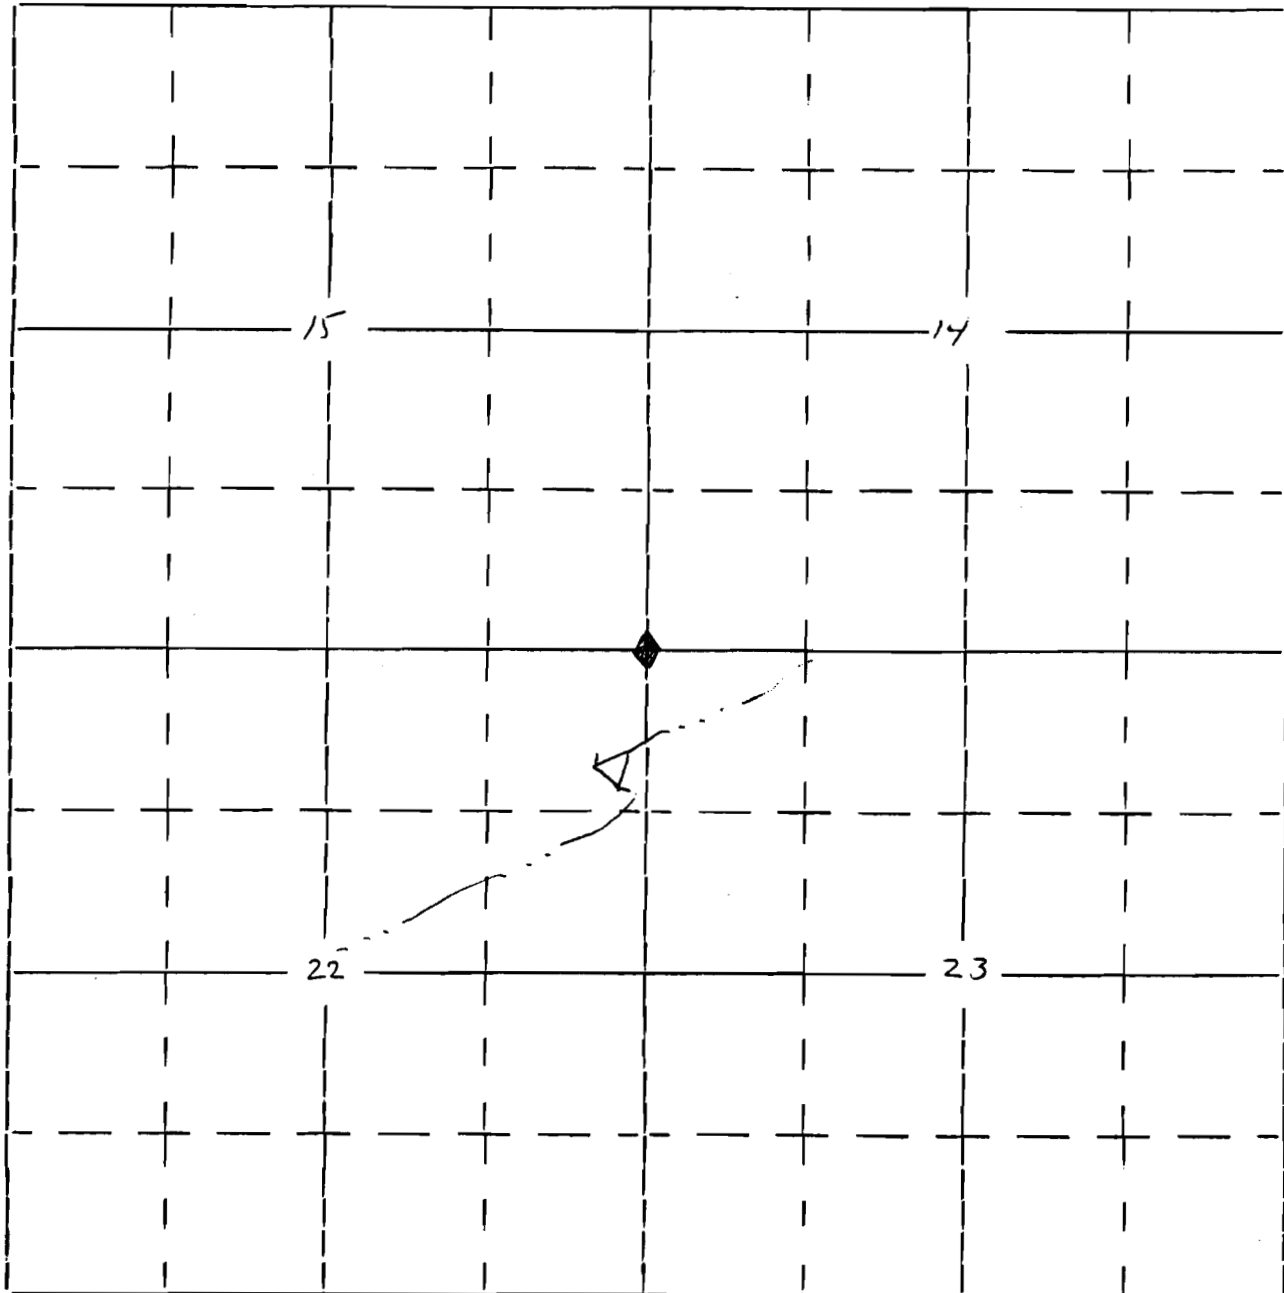

Project is 1,031' south and 437' west of corner common to sections
14, 15, 22 & 23.