

R9476
62604

Form OR-010-7300-2
4/83

UNITED STATES
DEPARTMENT OF THE INTERIOR
BUREAU OF LAND MANAGEMENT


Section 11
SW NE

Township 40S
Range 23E

Appl. No. R67612
Permit No. R 9476

Will. Mer.

Needed Reservoir #1144

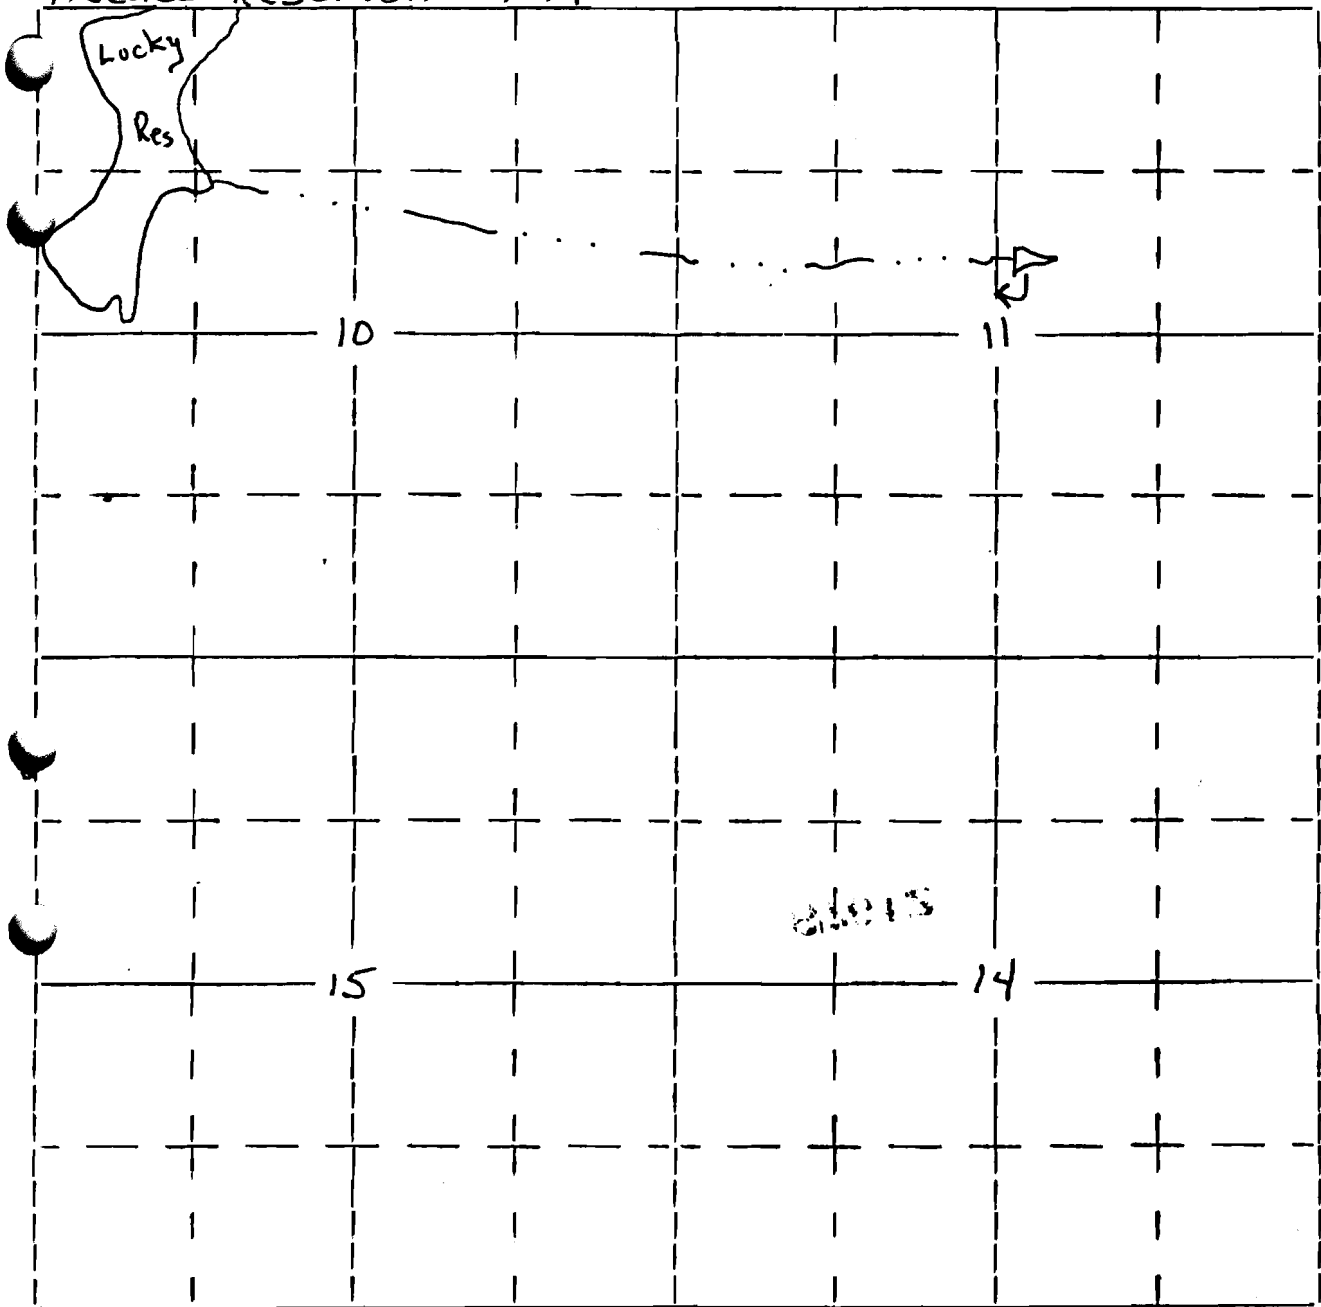

1950's 2,450 W of the NE corner of section 11