

R9478
62605-

Form OR-010-7300-2
4/83

UNITED STATES
DEPARTMENT OF THE INTERIOR
BUREAU OF LAND MANAGEMENT


Section 29
NE SW

Township 38 south
Range 26 east

Appl. No. R67614
Permit No. R 9478

Will. Mer.

Six Reservoir (#1528)

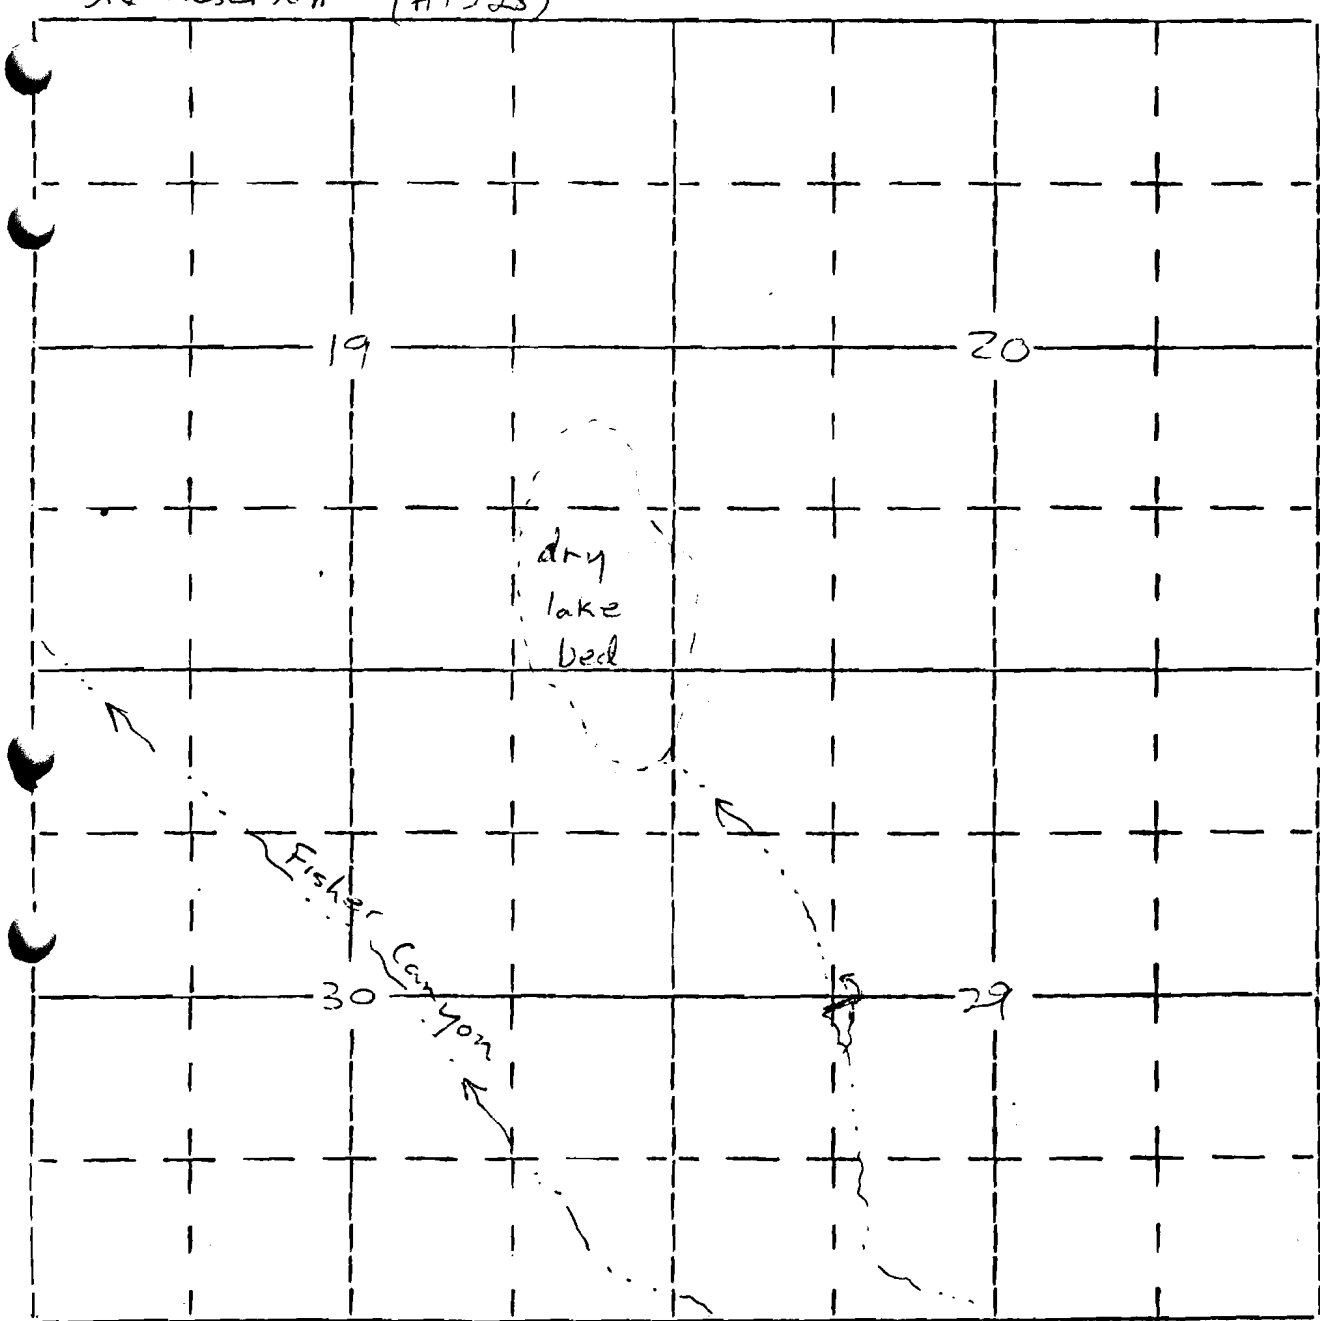

2520' N., 1430' E of SE corner of Section 29
C.C.B.