

R9480
62606

Form OR-010-7300-2
4/83


UNITED STATES
DEPARTMENT OF THE INTERIOR
BUREAU OF LAND MANAGEMENT

Section 6
NENE

T.4DS.
R.23E.
WM

Appl. No. R67616
Permit No. R 9480

Jeep Trail Reservoir #4906

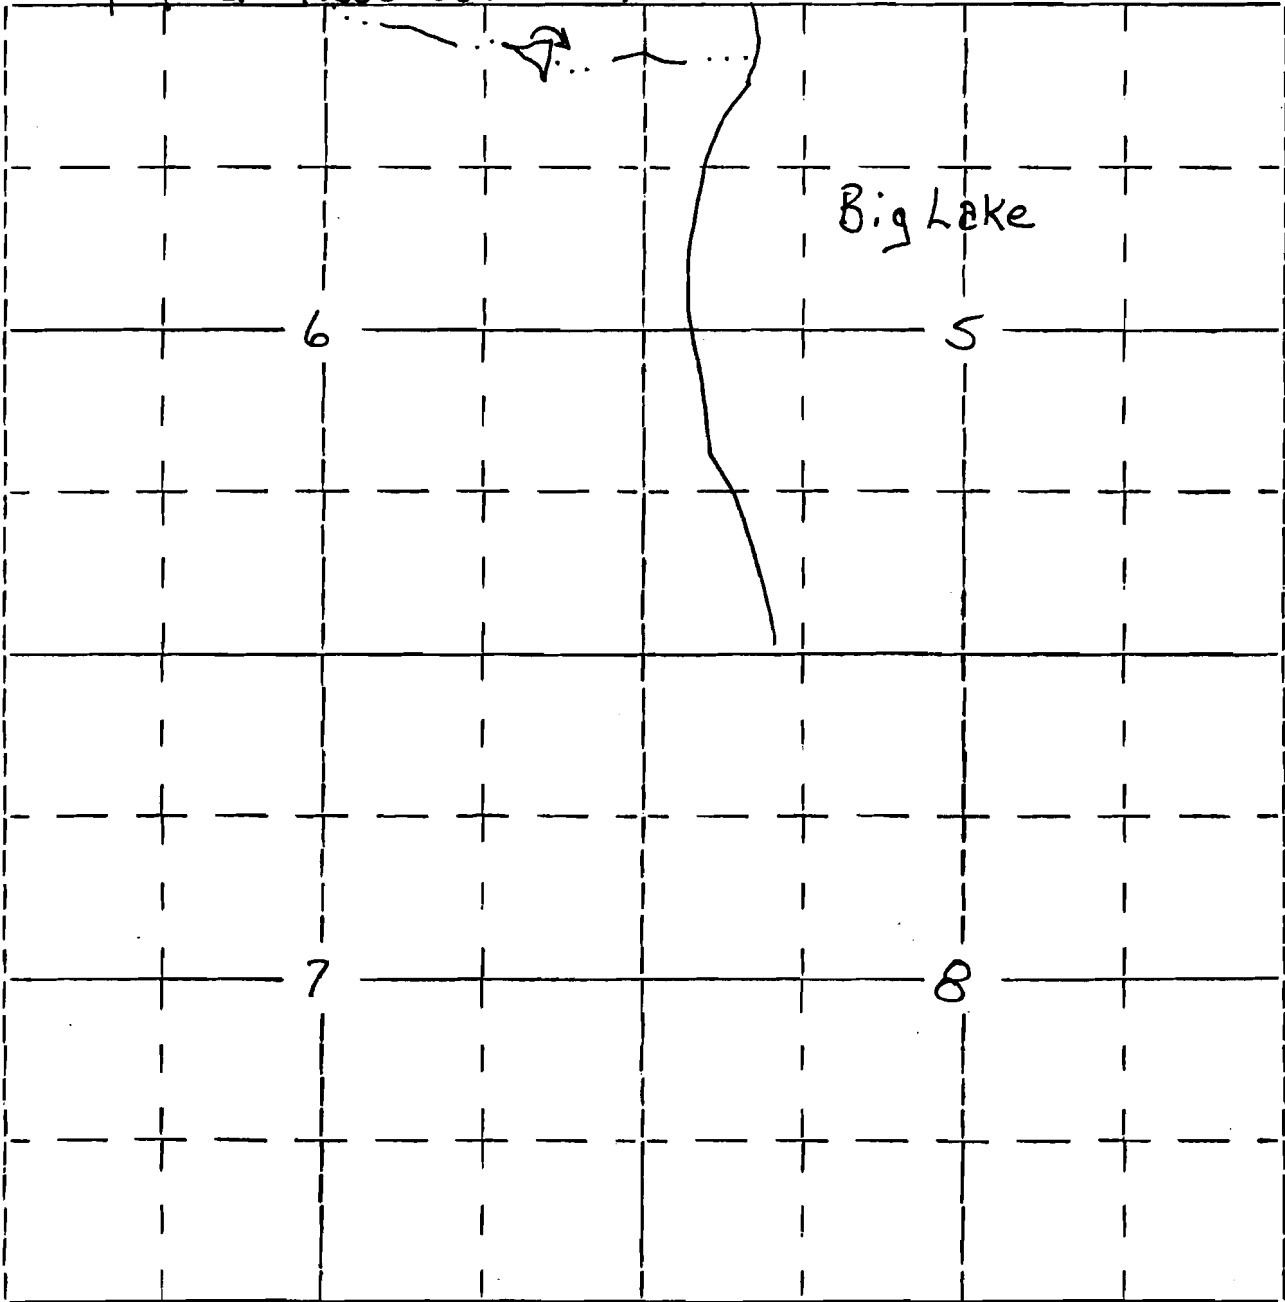

400'S 1,100'W of the NE corner of section 6