

R9481
62607

Form OR-010-7300-2
4/83

UNITED STATES
DEPARTMENT OF THE INTERIOR
BUREAU OF LAND MANAGEMENT


Section 2
SWSW

Township 40S
Range 23E

Appl. No. R67617
Permit No. R 9481

Will. Mer.

Good Lil Hole (5243)

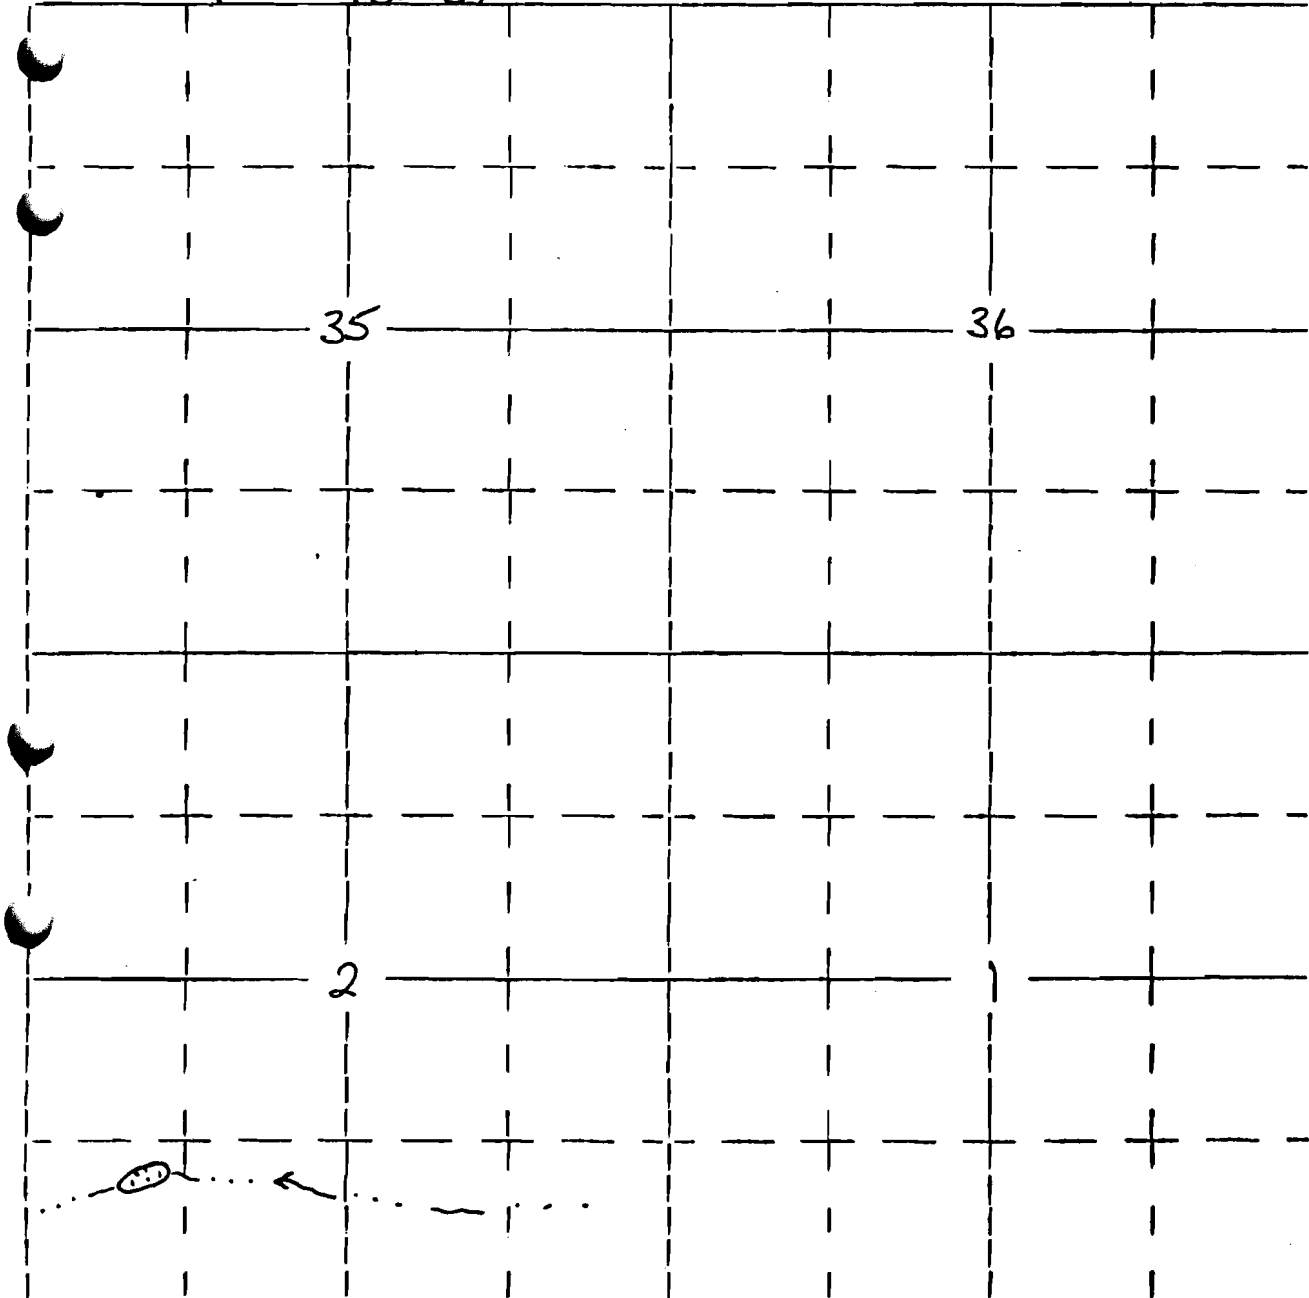

1,100' N 1000' E of the SW corner of section 2
11250' E