

R9482
62608

Form OR-010-7300-2
4/83

UNITED STATES
DEPARTMENT OF THE INTERIOR
BUREAU OF LAND MANAGEMENT

Section

9


SW NE

Township 39 south
Range 26 east

Appl. No. R67618

Permit No. R 9482

Rick Reservoir (#5379)

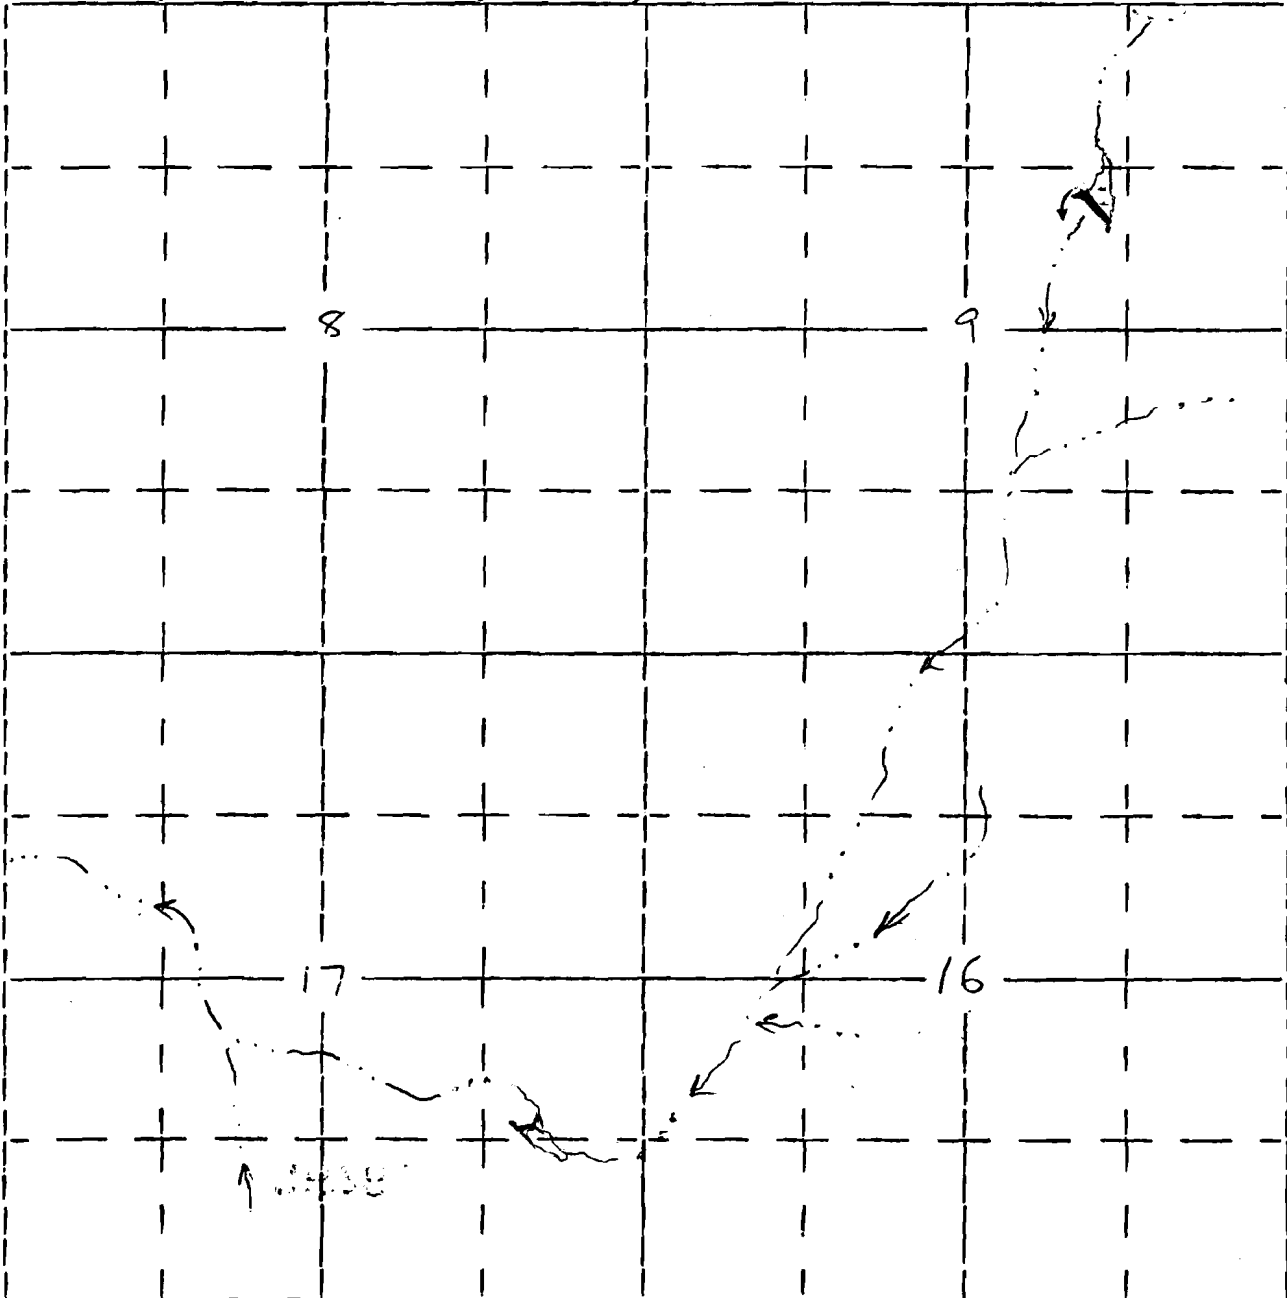

1650' S., 1585' W. of NE corner of section 9