

R9483
62609

Form OR-010-7300-2
4/83

UNITED STATES
DEPARTMENT OF THE INTERIOR
BUREAU OF LAND MANAGEMENT

Section 4

Township 40S

Appl. No. R67619


NE NW

Range 25E

Permit No. R 9483

Will. Mer.

Burro Springs Reservoir (5504)

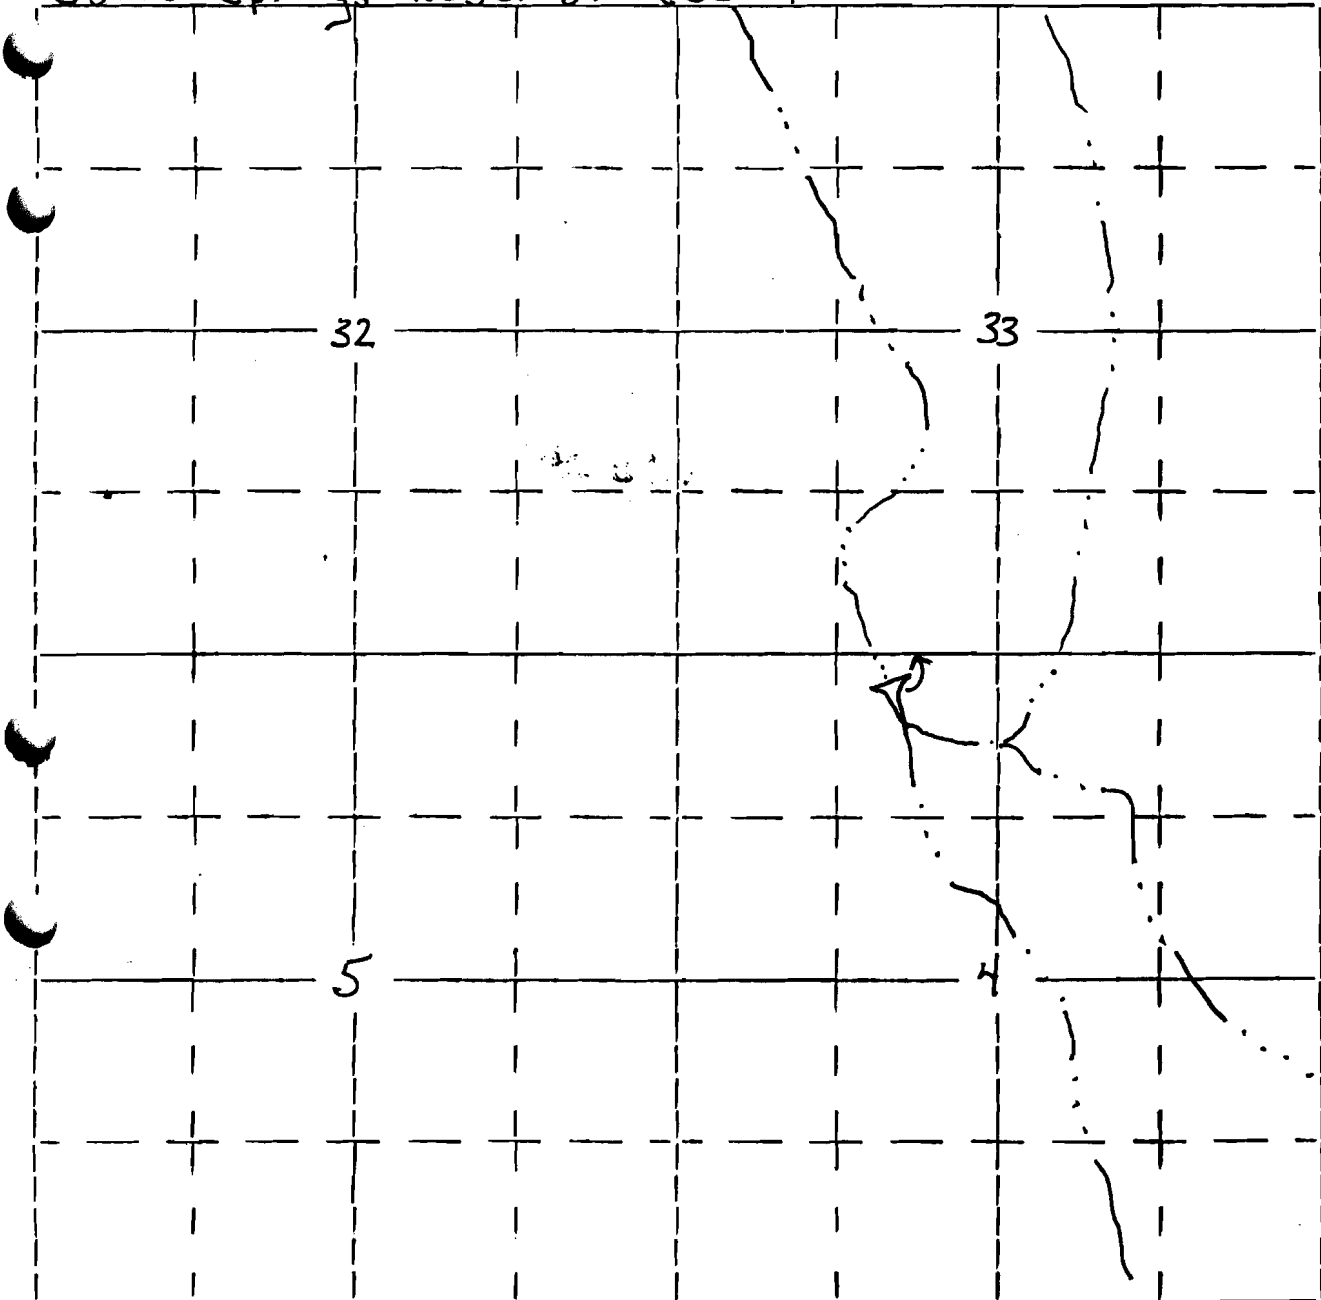

500'S 1800'E of the NW corner of section 4