

R9484
62610

Form OR-010-7300-2
4/83

UNITED STATES
DEPARTMENT OF THE INTERIOR
BUREAU OF LAND MANAGEMENT


Section 6
SESW

Township 40S
Range 23E

Appl. No. R67620
Permit No. R 9484

Will. Mer.

Wakefield Reservoir #7 4146

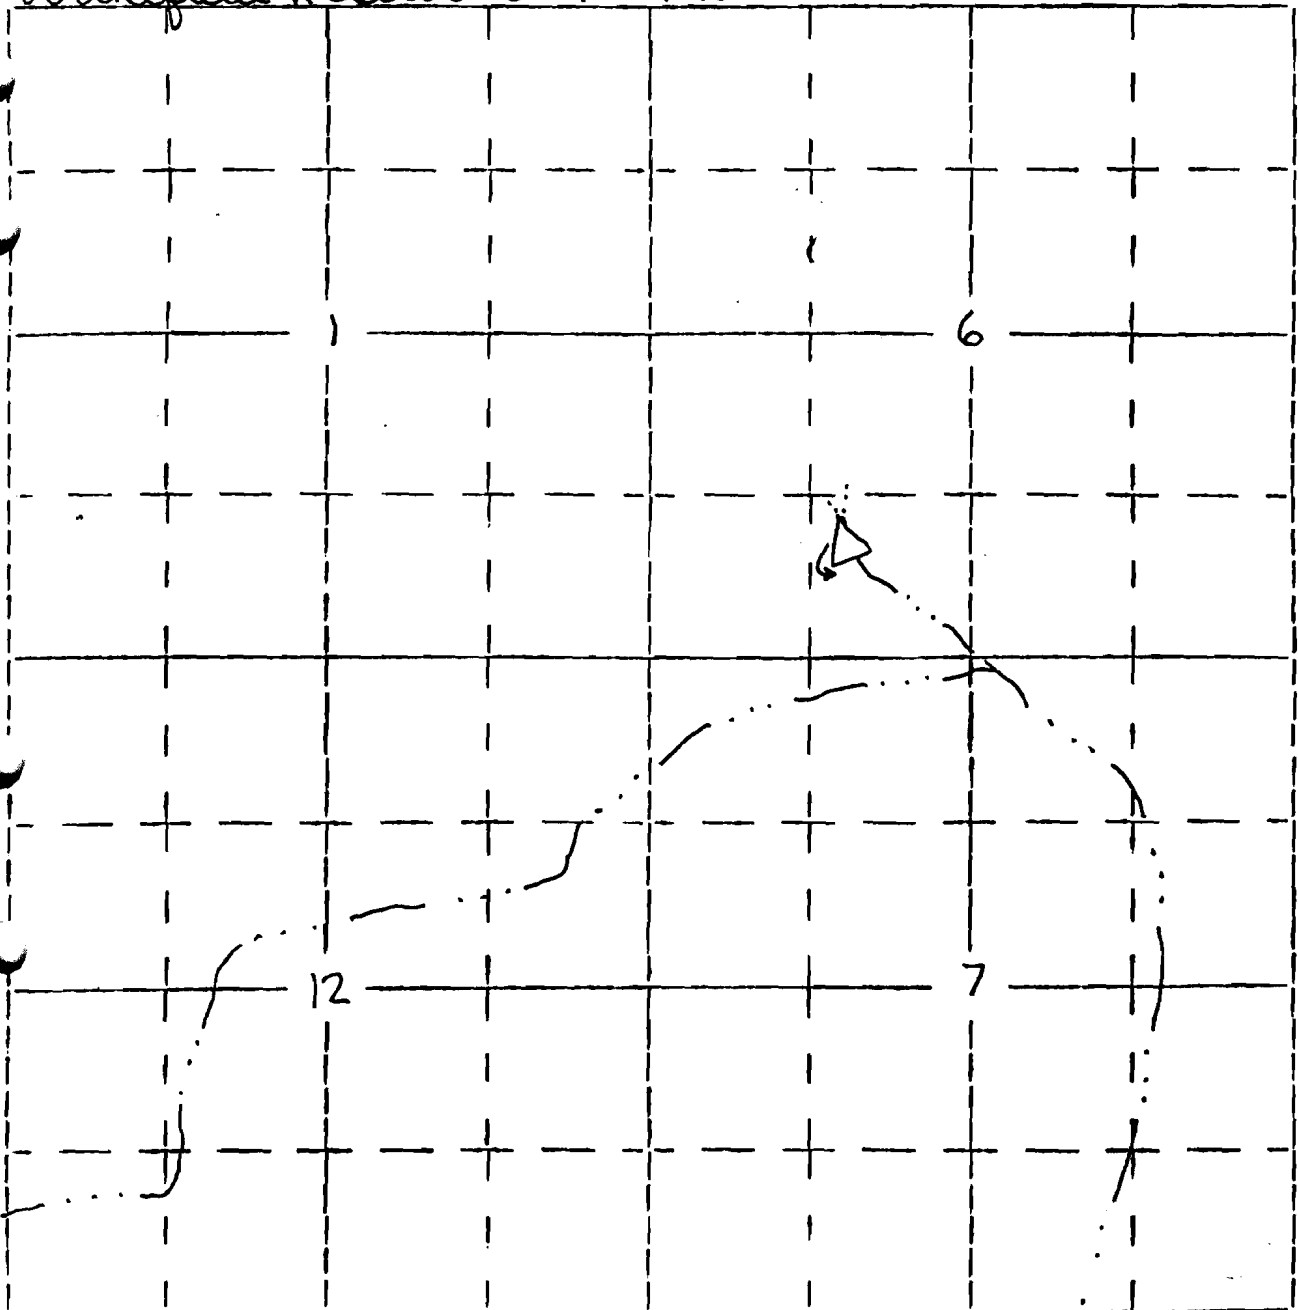

800' N 1550' E of the SW corner of section 6