

R9486
62611

Form OR-010-7300-2
4/83


UNITED STATES
DEPARTMENT OF THE INTERIOR
BUREAU OF LAND MANAGEMENT

Section
22
SW SE

Township 40 south
Range 23 east

Appl. No. R67623
Permit No. R 9486

Black Velvet Reservoir (#5242)

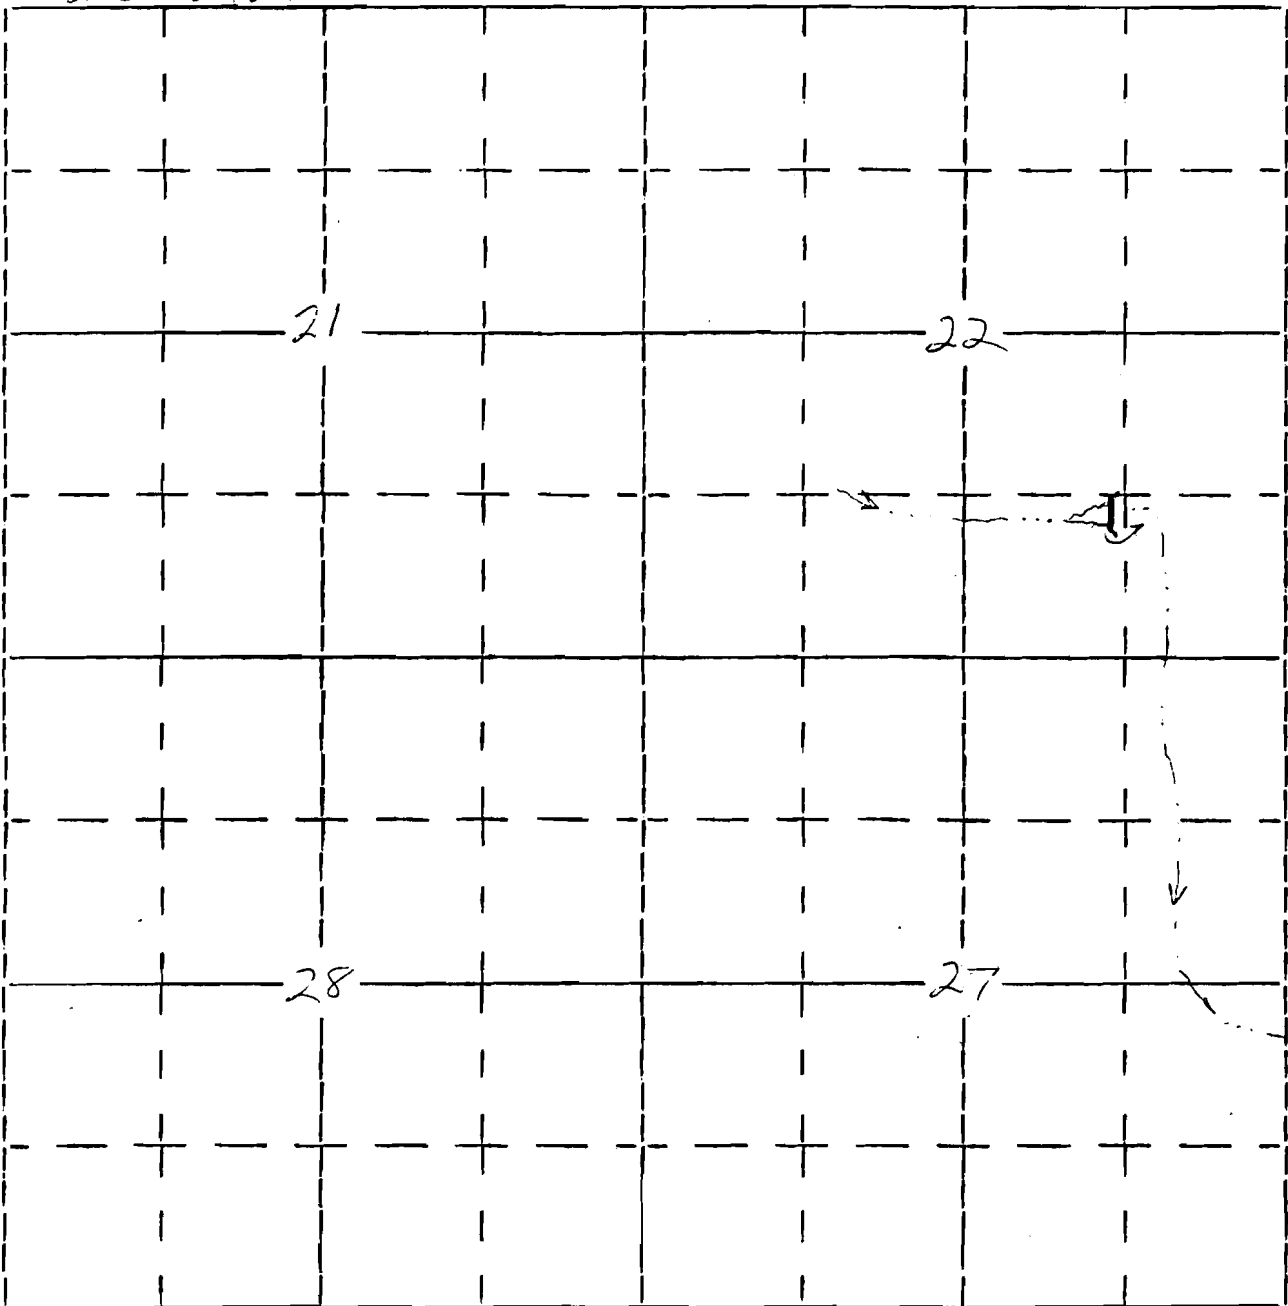

1190' N., 1450' W. of SE Corner, section 22

SEE FIGURE