

R9487
62612

Form OR-010-7300-2
4/83

UNITED STATES
DEPARTMENT OF THE INTERIOR
BUREAU OF LAND MANAGEMENT

Section

3

NW SW

Township 39 south

Range 25 east


Appl. No.

R67624

Permit No.

R 9487

User Reservoir # 2 (#0723)

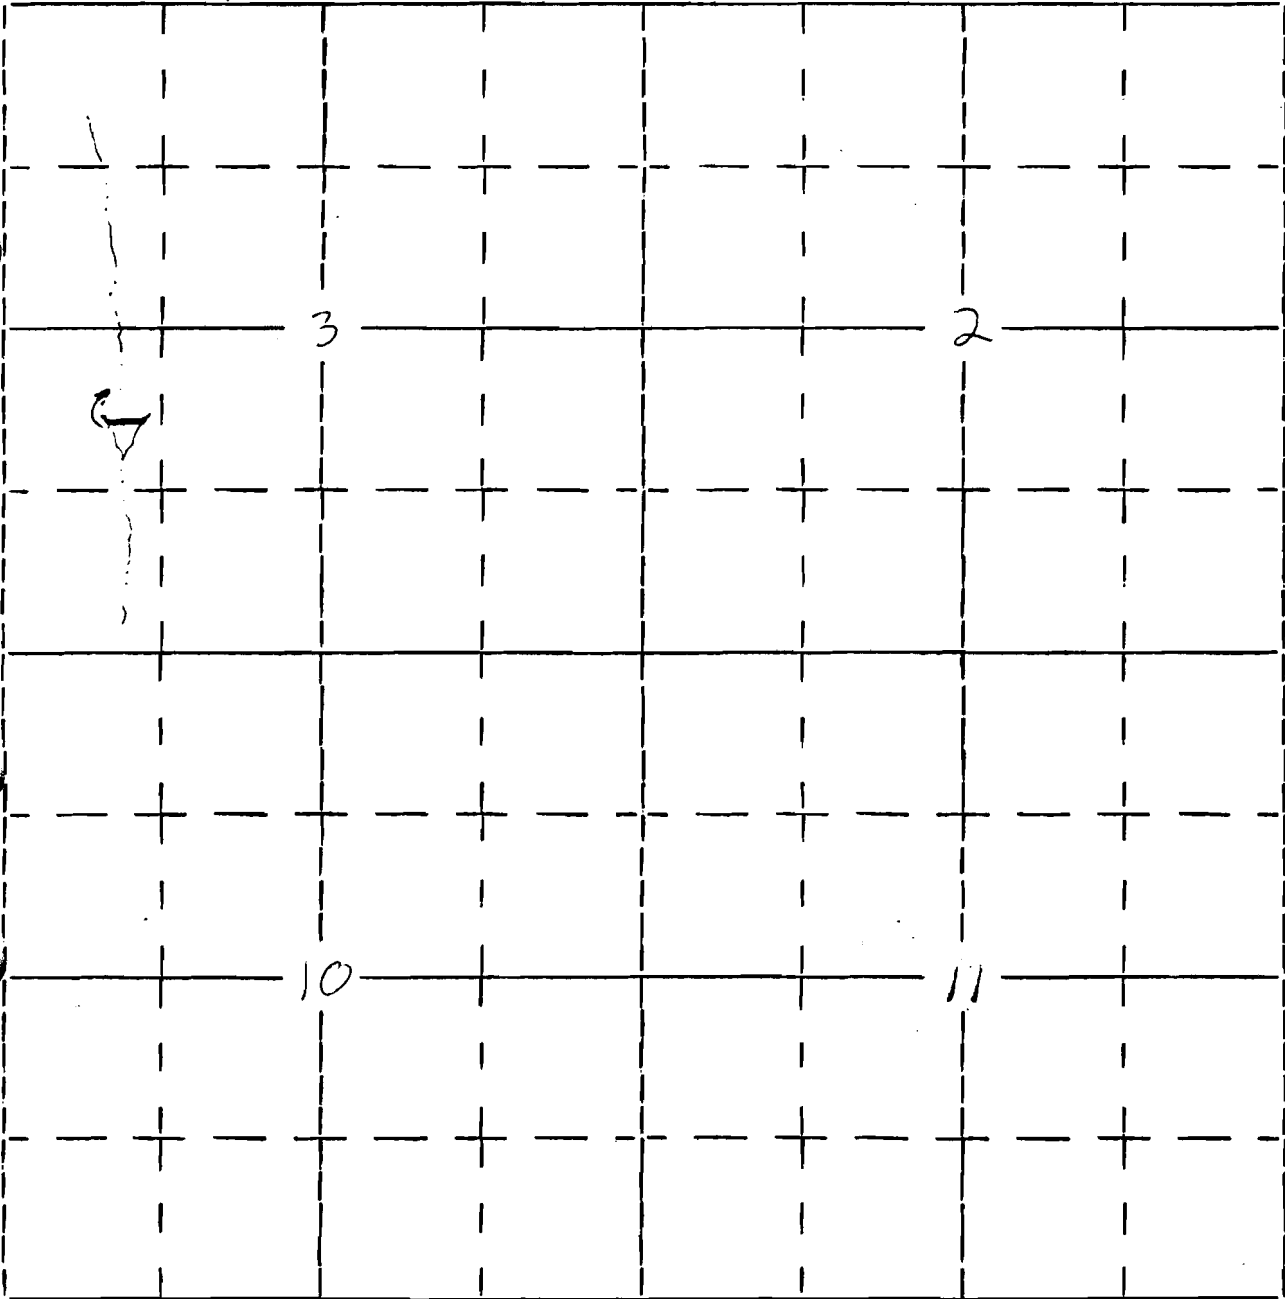

990' E., 1900' N. of the SW Corner, Section 3