

R9488
62613

Form OR-010-7300-2
4/83

UNITED STATES
DEPARTMENT OF THE INTERIOR
BUREAU OF LAND MANAGEMENT

Section 17

Township 35 S.

Appl. No. R67626


SE 1/4 SE 1/4

Range 23 E.

Permit No. R 9488

4 INCHES = 1 MILE

Will. Mer.

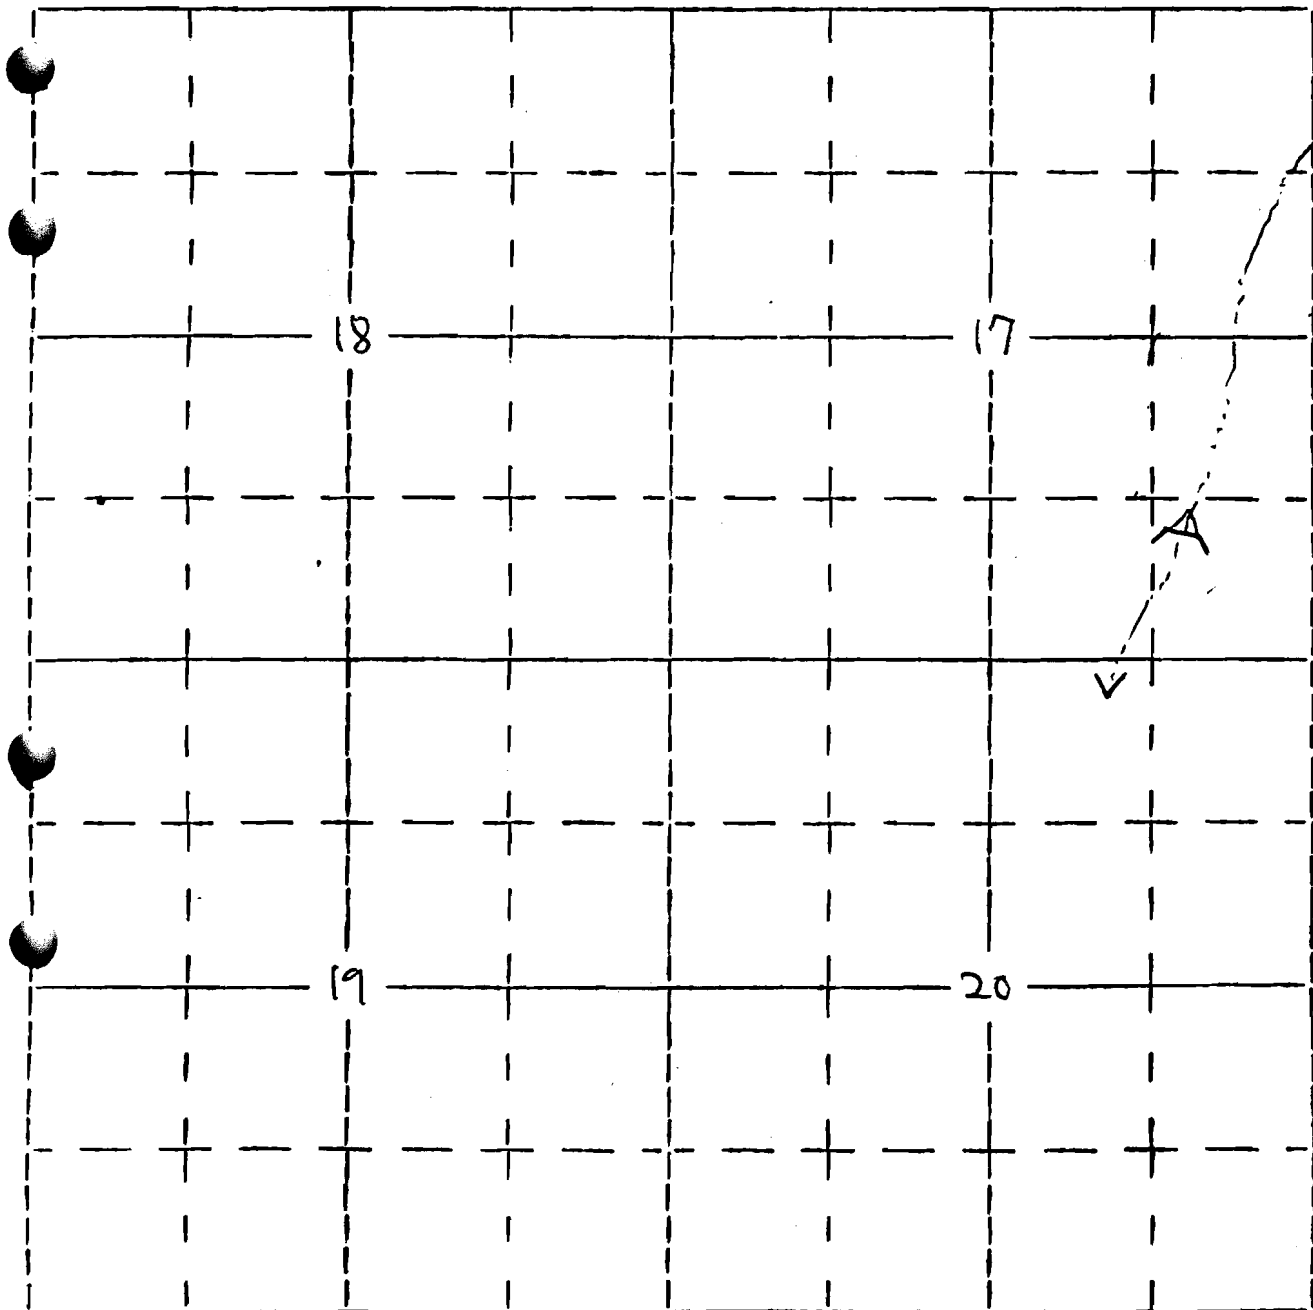

SPRING RESERVOIR CHECK # OR-010-R-4785
LOCATED 1,200 FEET NORTH AND 1,100 FEET
WEST OF THE SOUTHEAST CORNER OF SEC. 17.