

R9489
62614

Form OR-010-7300-2
4/83

UNITED STATES
DEPARTMENT OF THE INTERIOR
BUREAU OF LAND MANAGEMENT

Section 19

Township 35S

Appl. No. R67627


SENE

Range 23E

Permit No. R 9489

Will. Mer.

Staff Reservoir Check #4788

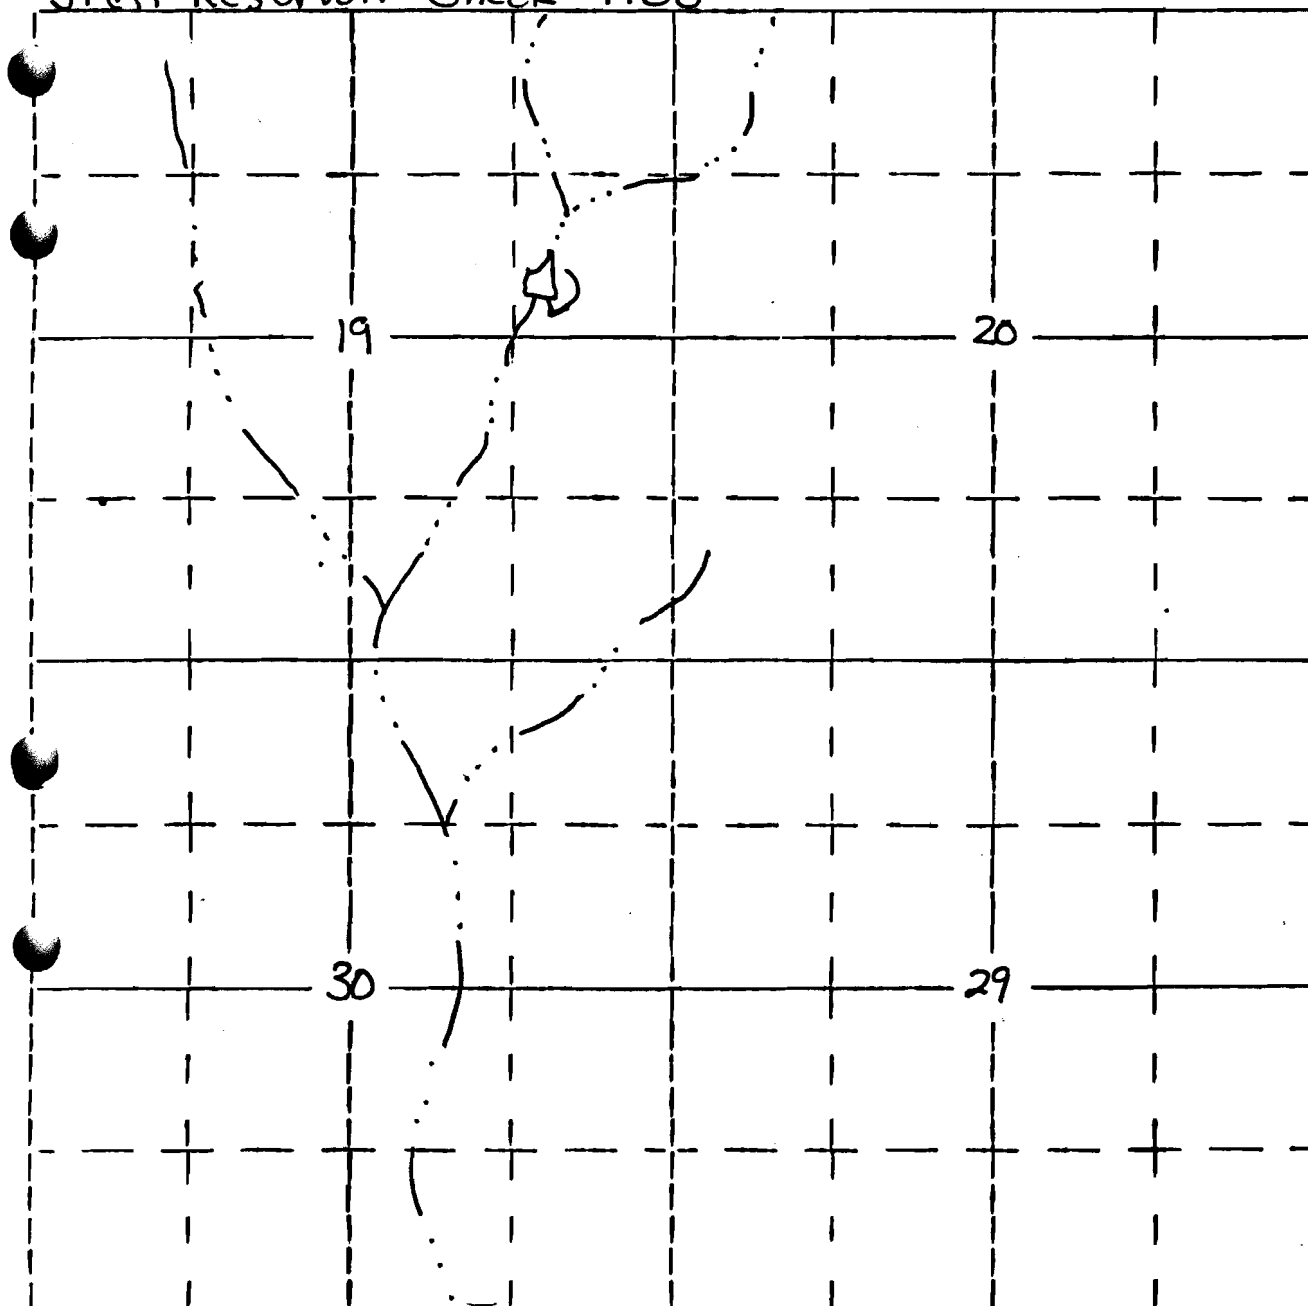

2150'S 1,150'W of the NE corner of section 19