

R9491
62616

Form OR-010-7300-2
4/83

UNITED STATES
DEPARTMENT OF THE INTERIOR
BUREAU OF LAND MANAGEMENT

Section 21

Township 35 S.

Appl. No. R67629

SW 1/4 NW 1/4


Range 23 E.

Permit No. R 9491

4 INCHES = 1 MILE

Will. Mer.

SIDE DRAW #4787

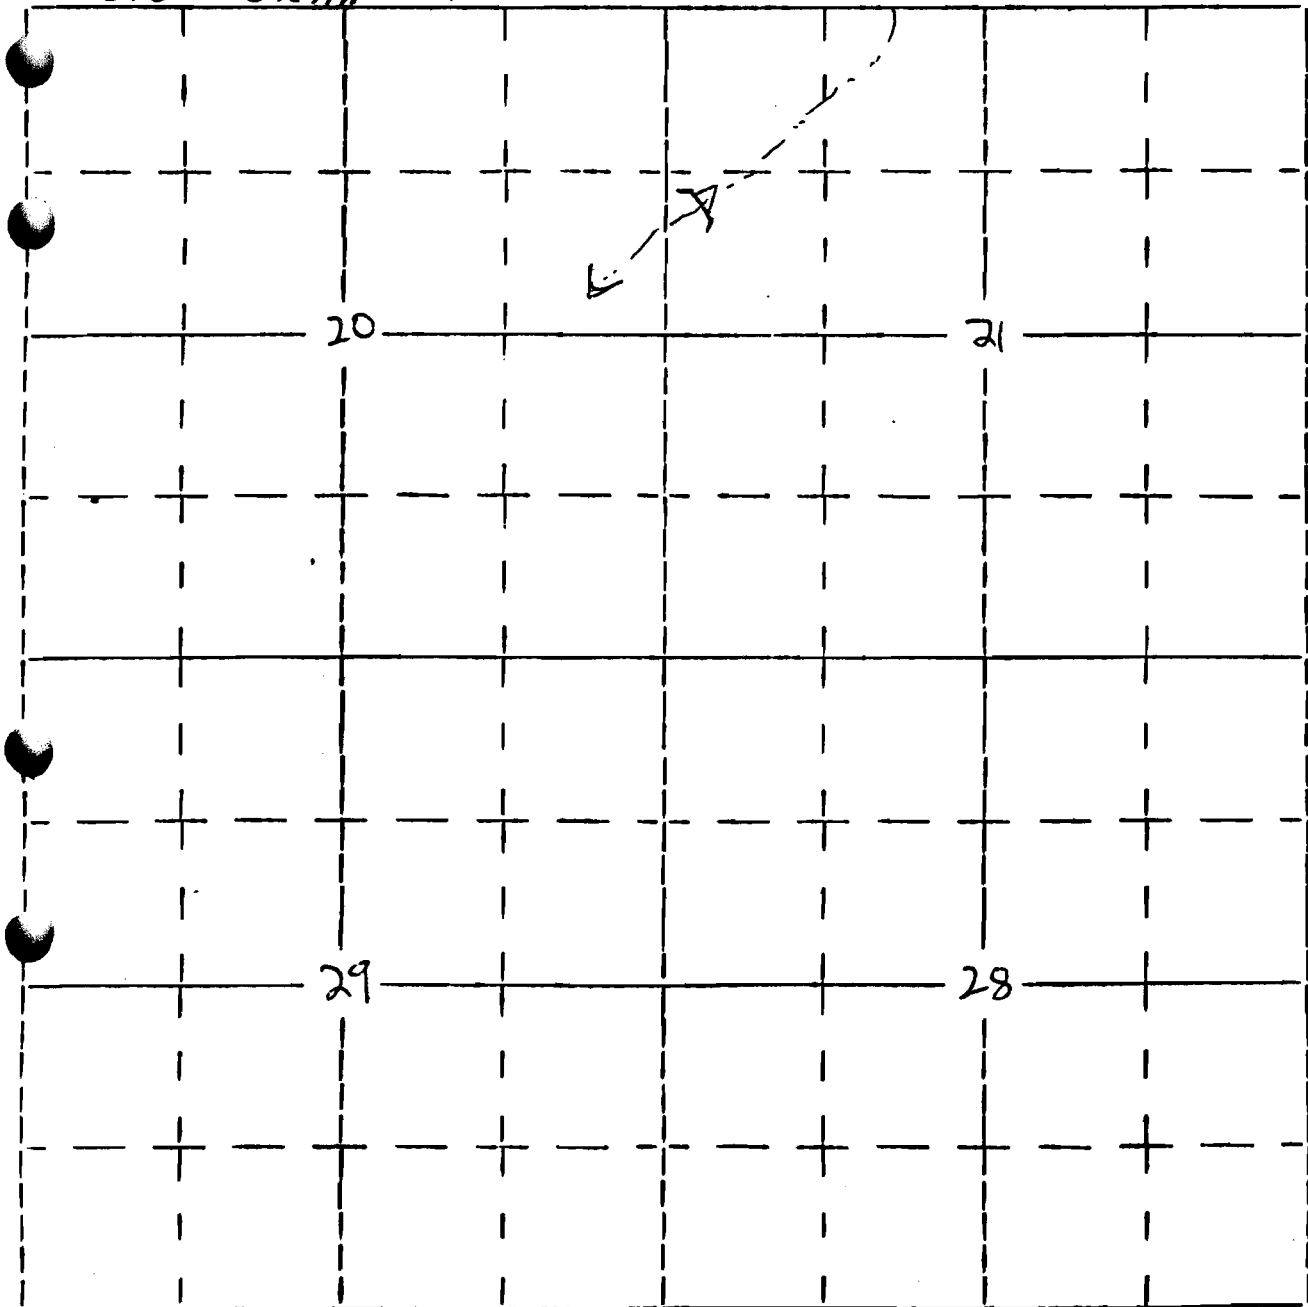

SIDE DRAW RESERVOIR # OR-010-R-4787
LOCATED 1,050 FEET SOUTH AND 700 FEET
EAST OF THE NORTHWEST CORNER OF SEC 21.