

R9492
62617

Form OR-010-7300-2
4/83

UNITED STATES
DEPARTMENT OF THE INTERIOR
BUREAU OF LAND MANAGEMENT

Section

18

Township 35S

Appl. No. R67630


SESE

Range 23E

Permit No. R 9492

Will. Mer.

Rocky Canyon Reservoir Check #4784

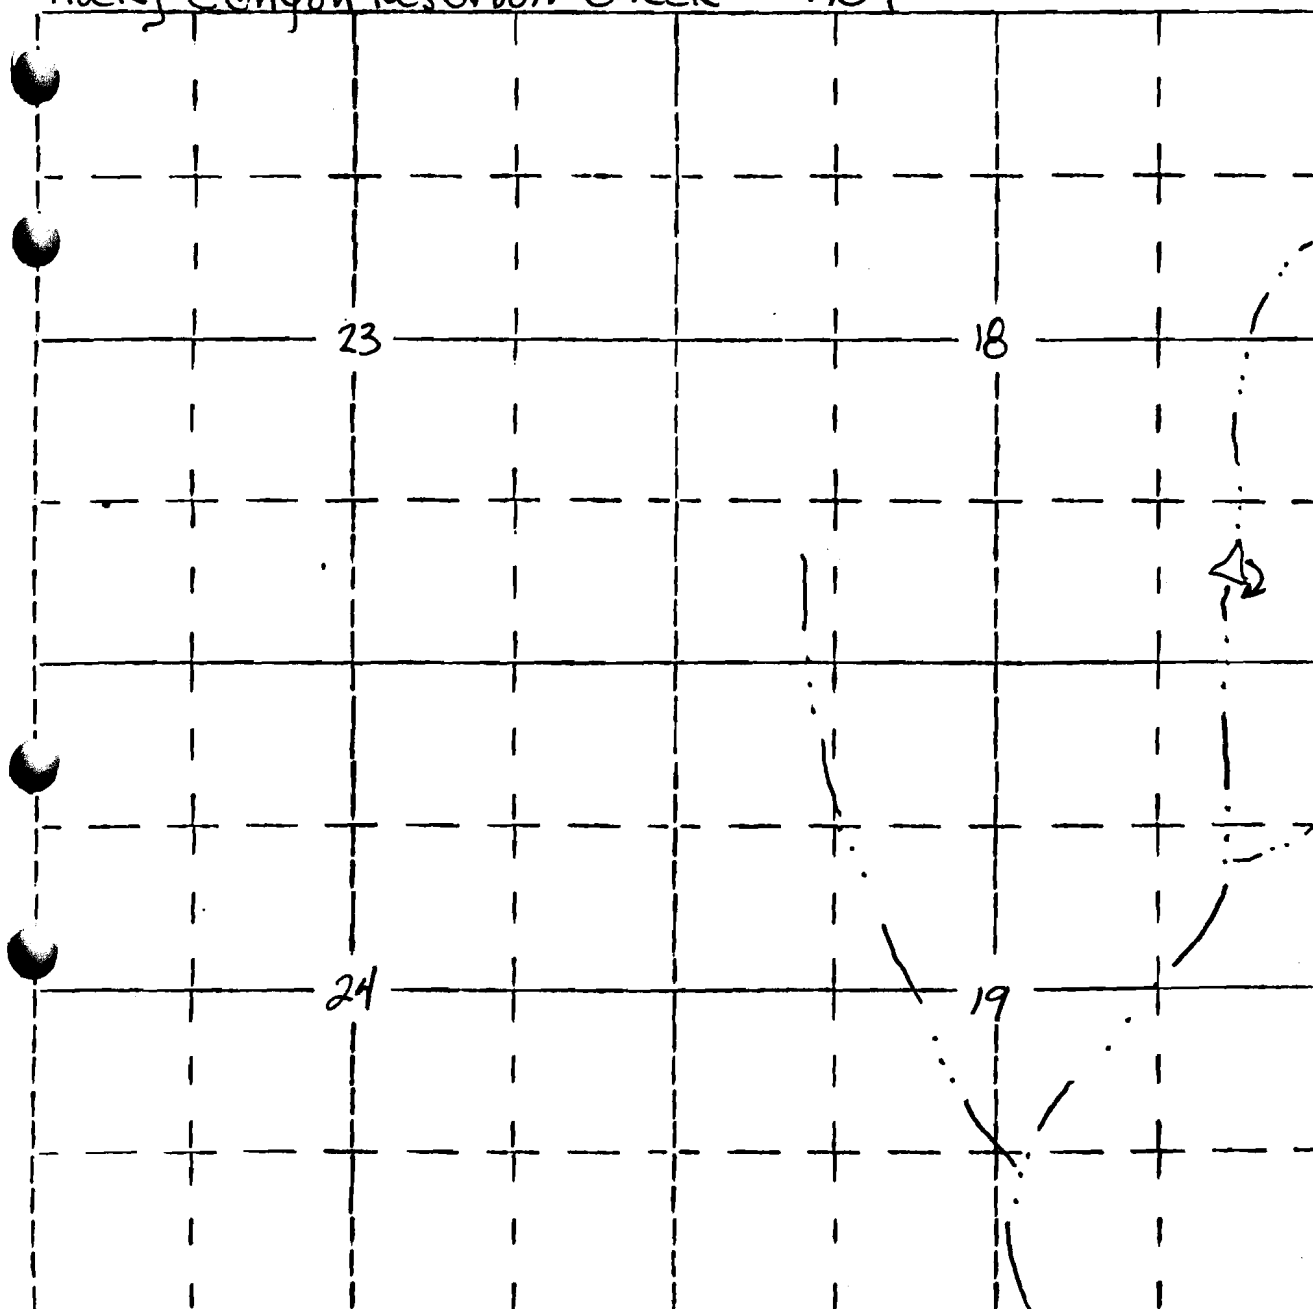

700' N 500' W of the SE corner of section 18

Return.