

R9493
62618

Form OR-010-7300-2
4/83

UNITED STATES
DEPARTMENT OF THE INTERIOR
BUREAU OF LAND MANAGEMENT


Section 24
NENW

Township 35 S
Range 23 E

Appl. No. R67631
Permit No. R 9493

Will. Mer.

Juniper Draw Check # 4783

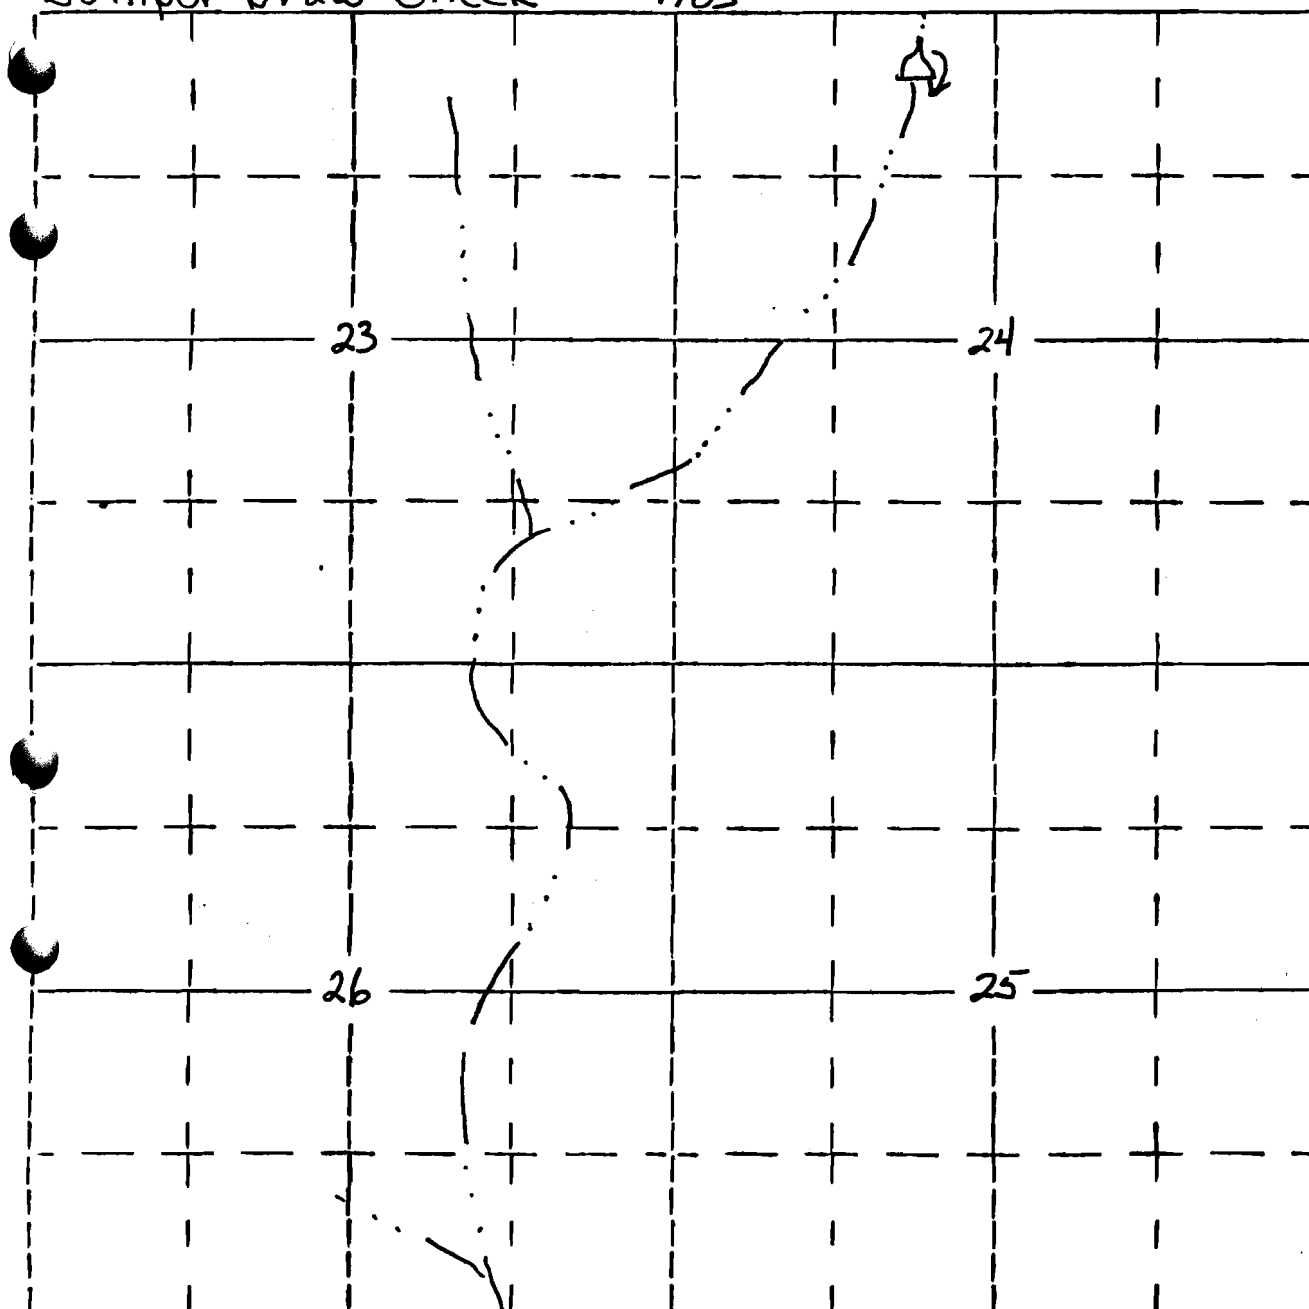

200'S 1950'E of NW corner of section 24