

R9494
62619

Form OR-010-7300-2
4/83

UNITED STATES
DEPARTMENT OF THE INTERIOR
BUREAU OF LAND MANAGEMENT

Section 7

Township 35S

Appl. No. R67632


NENW

Range 23E

Permit No. R 9494

Will. Mer.

No. Cement Spring Check #4779

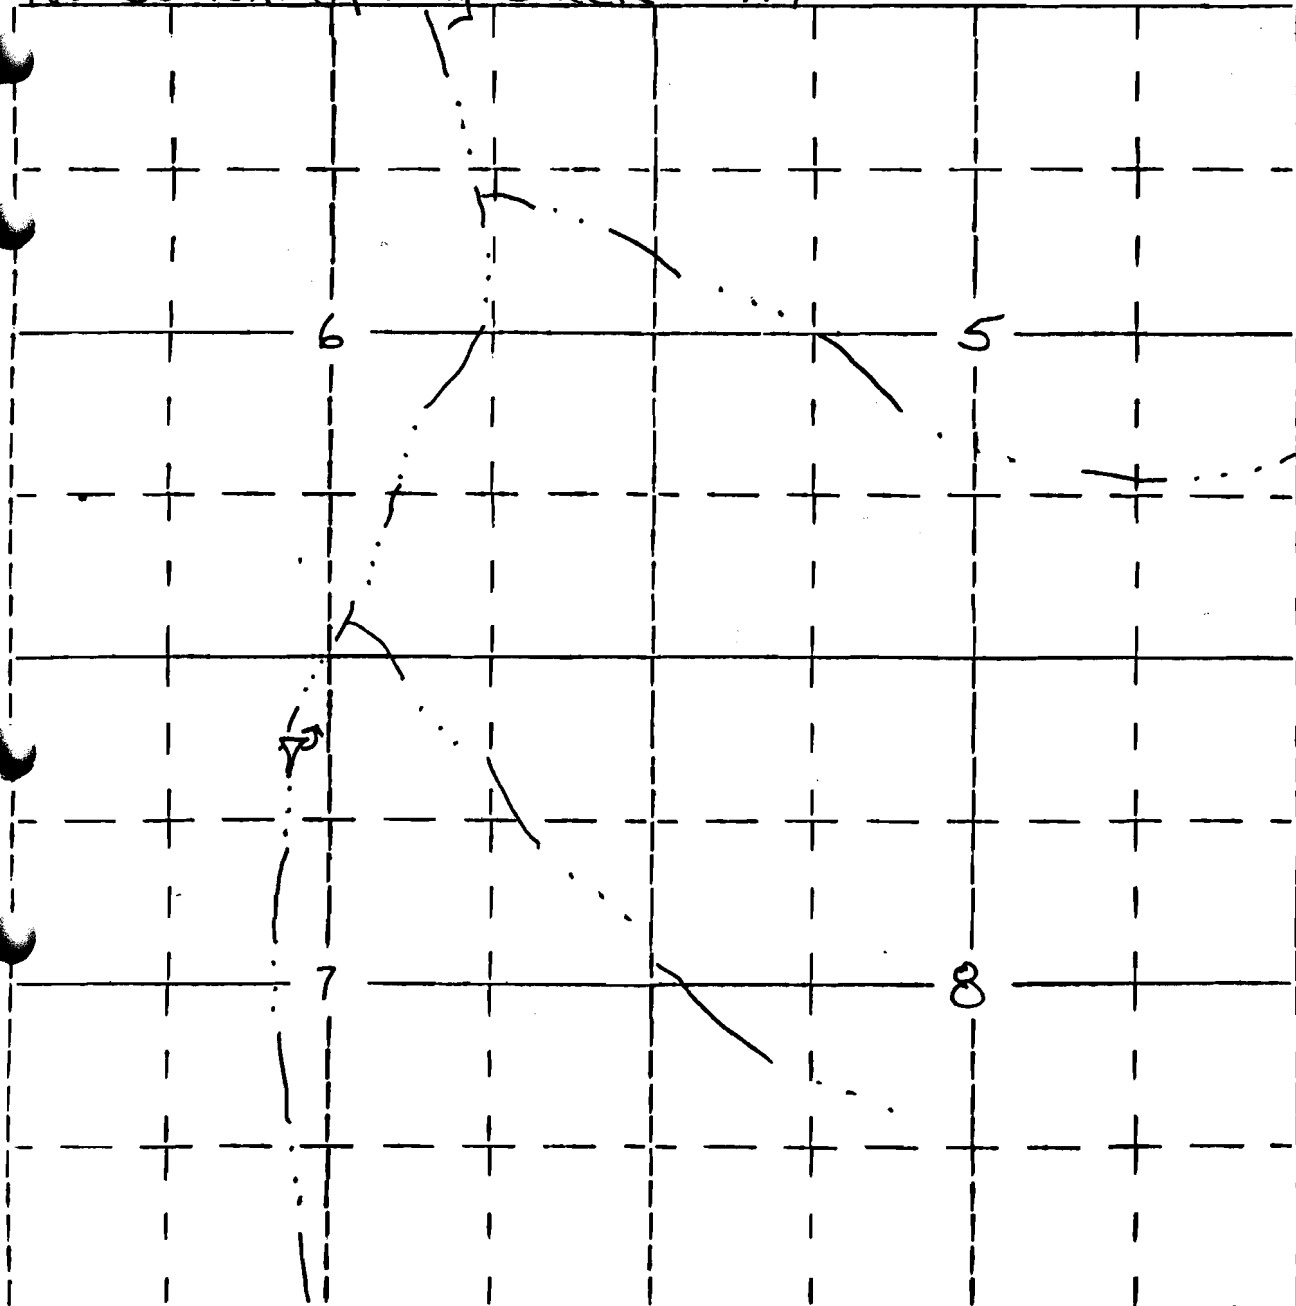

700'S 2,250'E of the NW Corner of Section 7

200' 200'