

R-9811
62620

Form OR-010-7300-2
4/83

UNITED STATES
DEPARTMENT OF THE INTERIOR
BUREAU OF LAND MANAGEMENT

Section

Township 40⁺41 S.


Appl. No. R-65599

31, 36, 1 & 6

Range 14⁺14¹/₂ E.

Permit No. R 9811

Will. Mer.

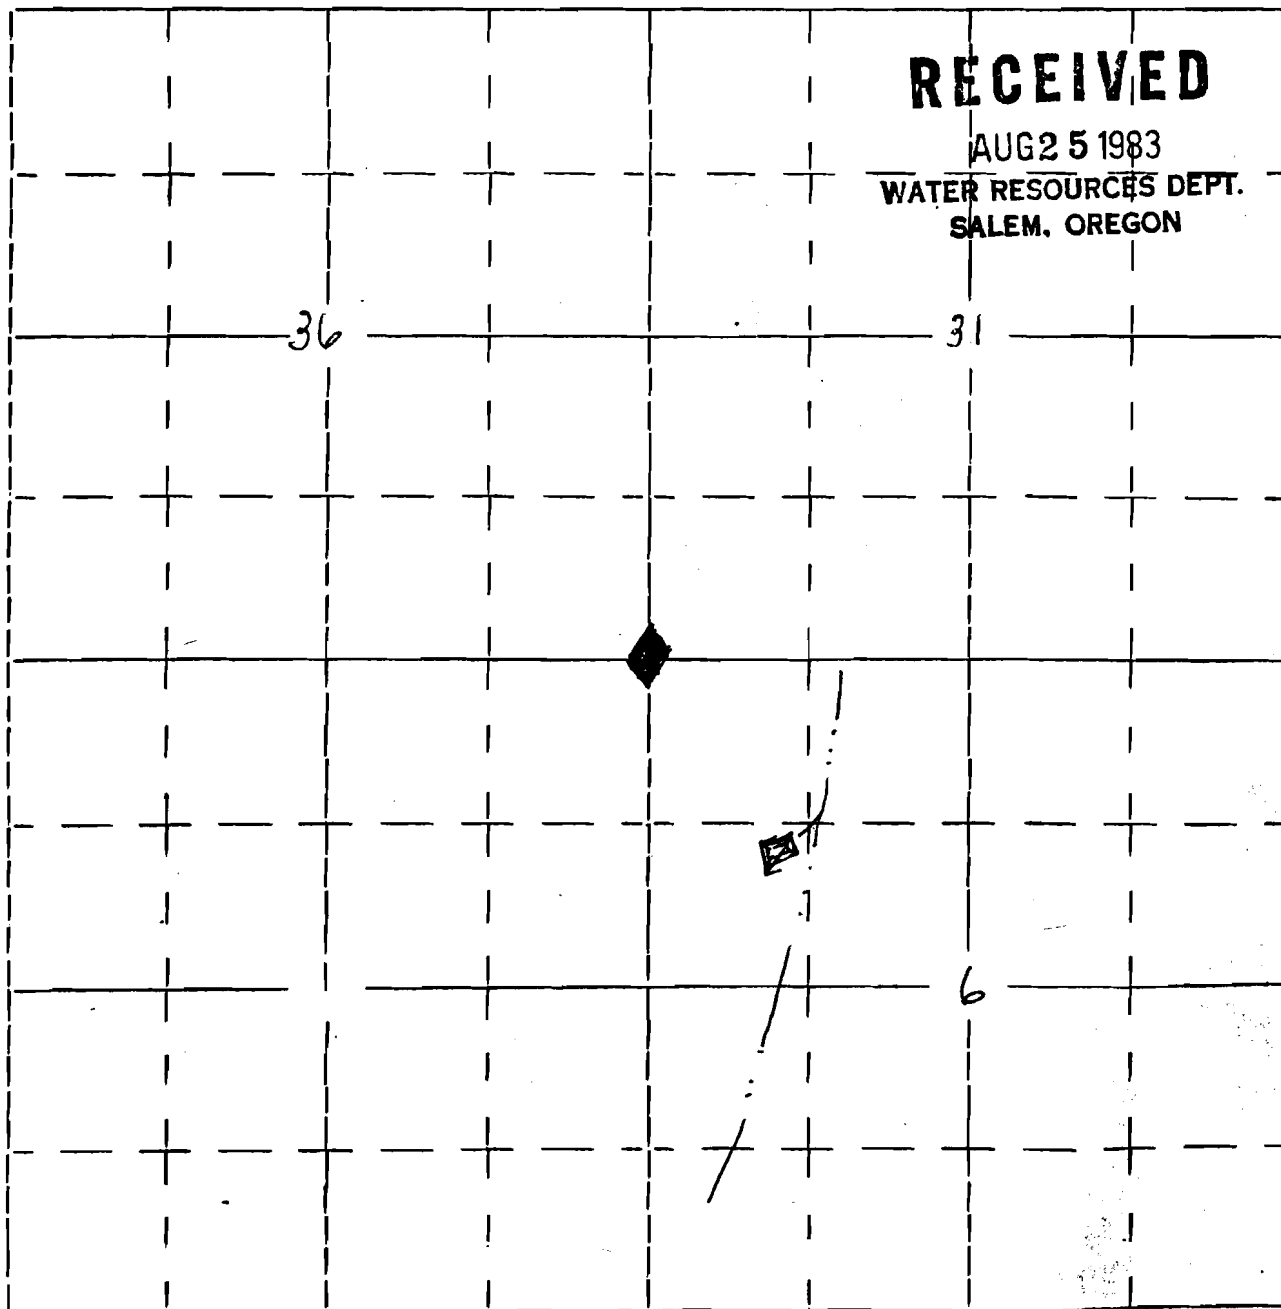

Project is located 1,478' south and 898' east of corner
common to sections 36, 1, 6 & 31.