

R-9812
(6262)

Form OR-010-7300-2
4/83

UNITED STATES
DEPARTMENT OF THE INTERIOR
BUREAU OF LAND MANAGEMENT

Section

Township 41 S.


Appl. No. R-65600

6, 1, 12 & 7

Range 14, 14½ E.

Permit No. R 9812

Will. Mer.

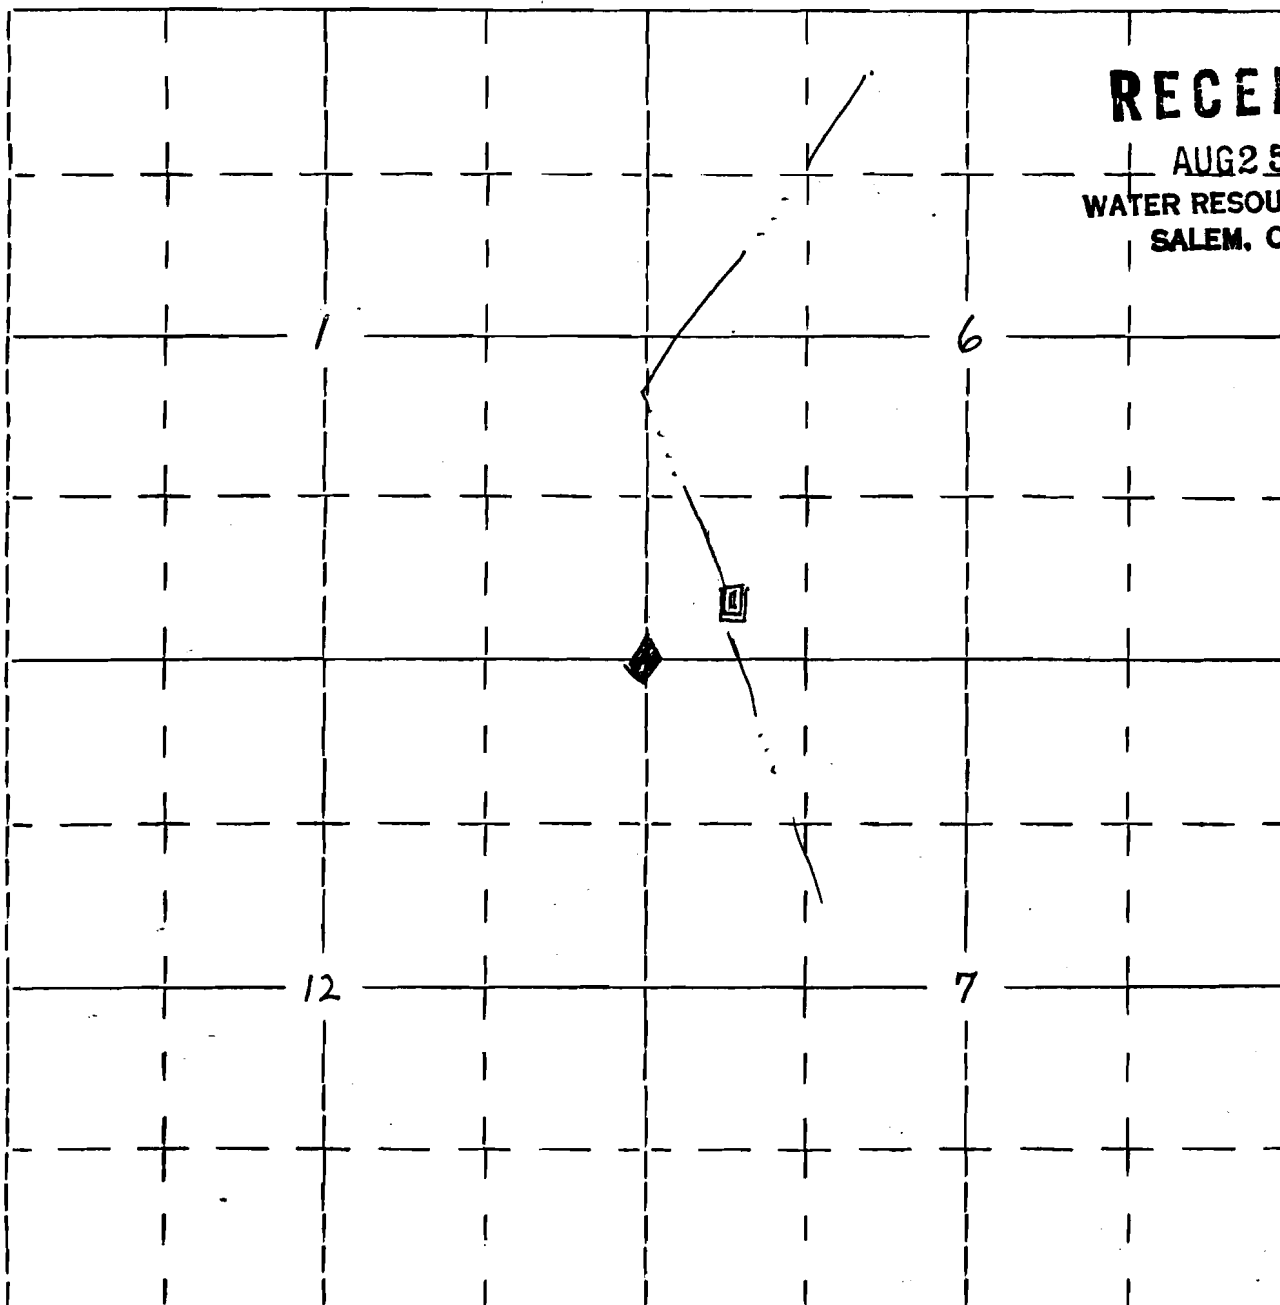

RECEIVED

AUG 25 1983
WATER RESOURCES DEPT.
SALEM, OREGON

Waterhole is located 264' north and 581' east of corner common to sections 6, 1, 12 & 7.